







**ALL BARS IN THIS DRAWING
ASTM A615 GRADE 60
BLACK UNCOATED**

LEGEND	
NO. OF LOCATION	NO. OF LIFT
NO. OF BARS	NO. OF BARS
2x3x2 #5x6'-6" VERTS	
NO. OF LIFT (OR) NO. OF LOCATION	NO. OF BARS
2x1 #5x6'-6" VERTS	
LIFT 1 TO LIFT 6	2x1 #5x6'-6" VERTS L1-L6

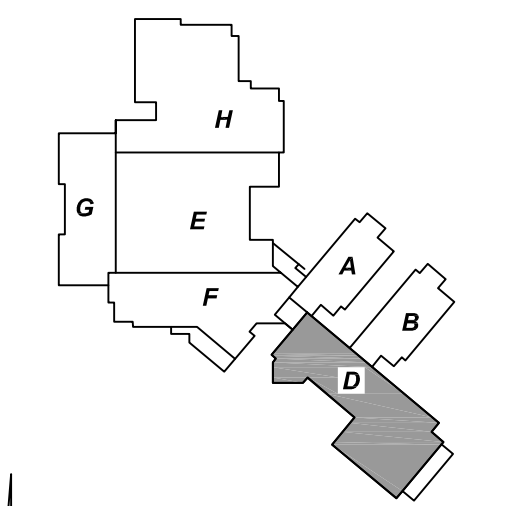


AREA KEY PLAN
REF: 3.23
SCALE: NTS

AREA-D CMU WALL LAYOUT
REF: 3.23
SCALE: 1/10" = 1'-0"

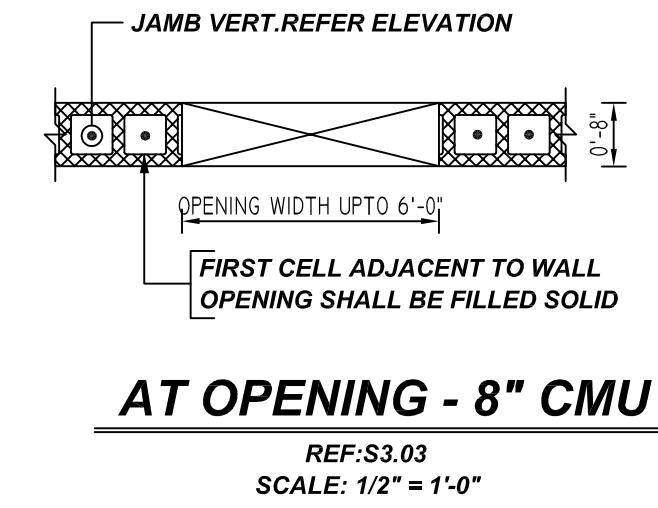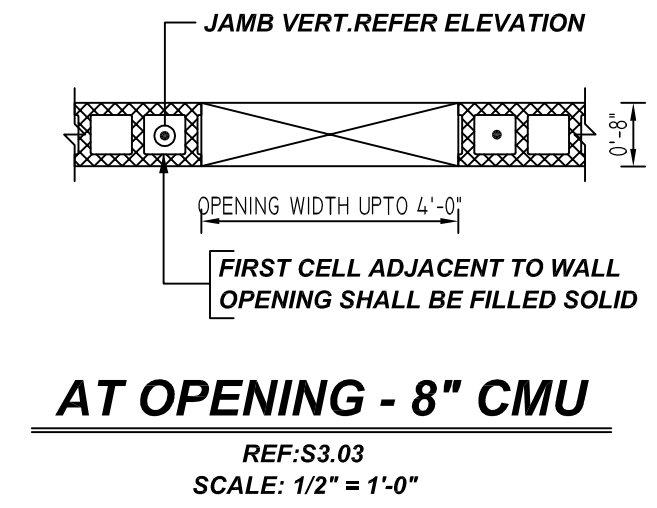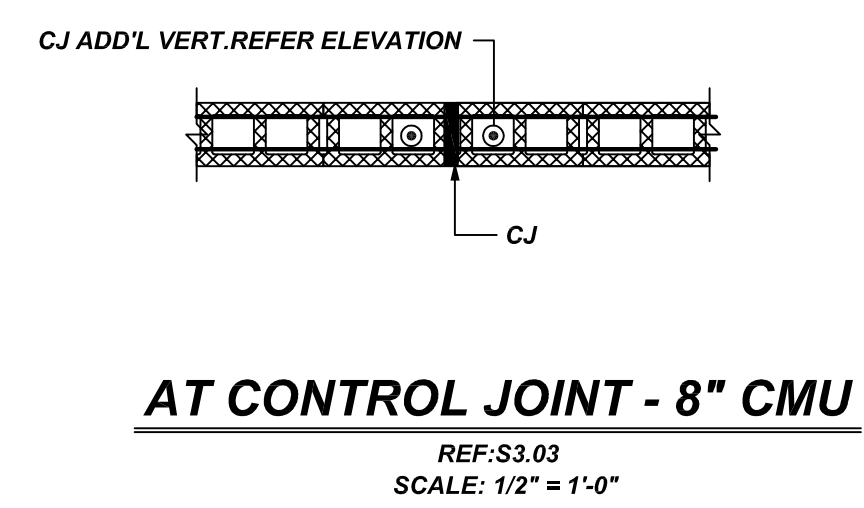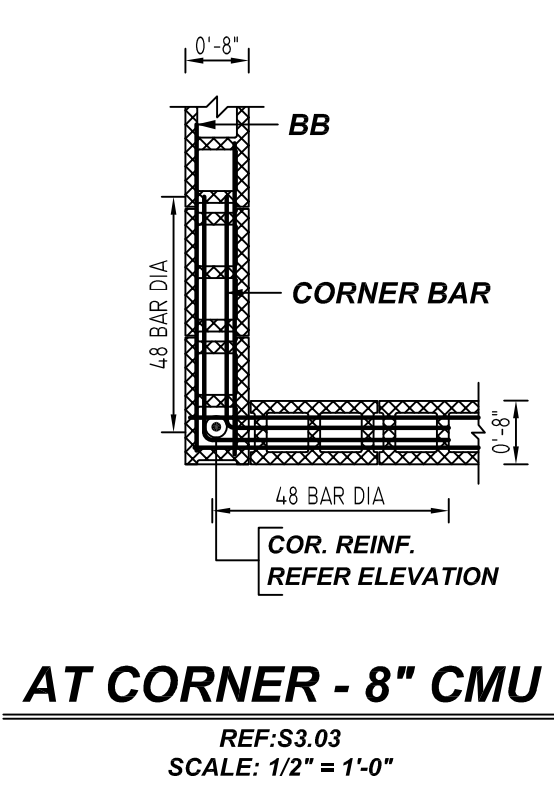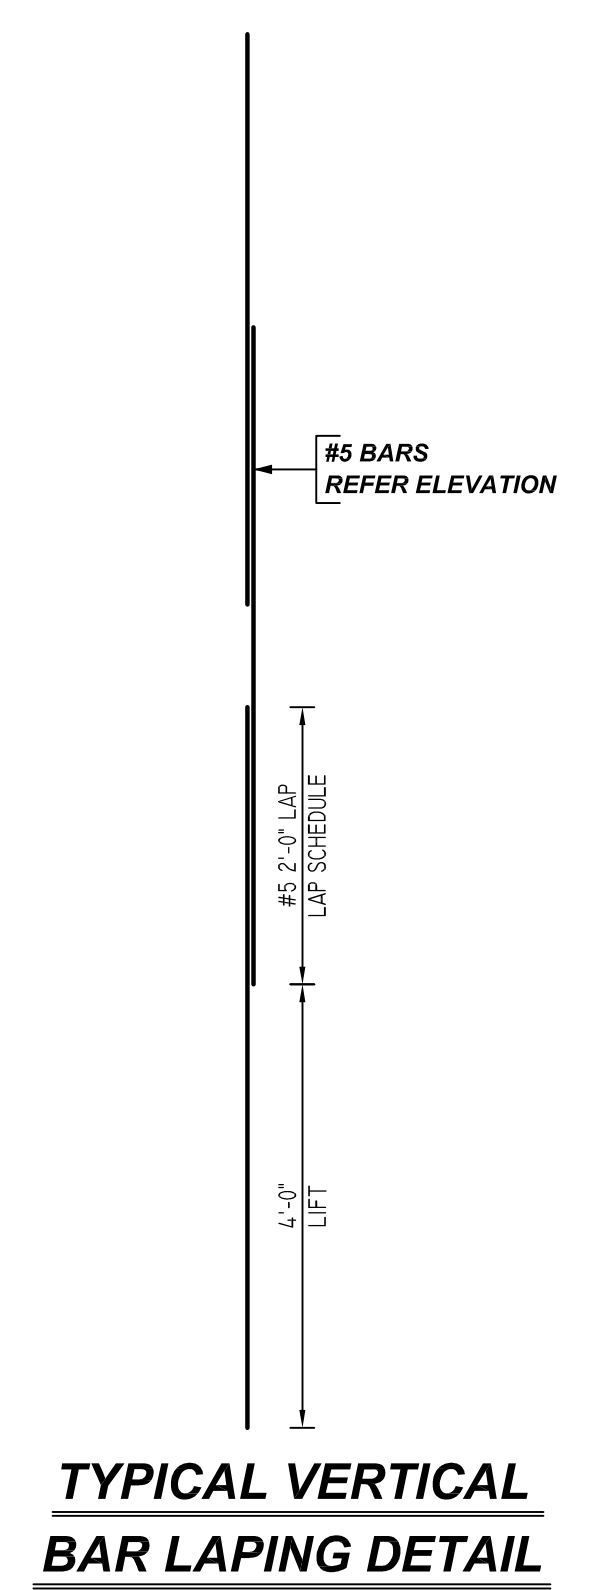


- PLACING PLAN NOTES**
1. THIS DRAWINGS FOR REBAR PLACEMENT ASSISTANCE ONLY. REFER TO STRUCTURAL DETAILS FOR CONTRACT REQUIREMENTS.
 2. SECTIONS / DETAILS / DIMENSIONS ON PLACING PLAN ARE FOR REFERENCE AND ARE TO BE USED IN CONJUNCTION WITH CONTRACT DRAWING FOR CRSI MANUAL OF STANDARD PRACTICE.
 3. REINFORCING STEEL IS DETAILED PER CONTRACT DOCUMENTS ONLY AS SHOWN CODE COMPLIANCE REQUIREMENTS ARE THE RESPONSIBILITY OF ENGINEER AND / OR CONTRACTOR.
 4. THE CONTRACTORS UNDERSTANDS THAT THE ENGINEER SHOULD ALWAYS VERIFY SHOP DRAWINGS IF TIME DOES NOT ALLOW FOR APPROVALS. TEXAS REBAR IS NOT HELD RESPONSIBLE FOR UNAPPROVED SHOP DRAWINGS USED IN PLACING CRSI MANUAL OF STANDARD PRACTICE THE CUSTOMER AND ENGINEER SHOULD REVIEW SHOP DRAWINGS PRIOR TO INSTALLATION TO VERIFY ACCURACY TO STRUCTURAL DRAWINGS.
- PLACING PLAN NOTES**
1. DIMENSIONS ELEVATIONS & DRAWINGS SCALES SHOWN ARE FOR REFERENCE ONLY CONTRACTOR TO PROVIDE LINES, GRADES & TEMPLATES REQUIRED FOR PLACEMENTS.
 2. SECTIONS & DETAILS MAY NOT BE SHOWN ON ALL PLACING PLANS. KEEP STRUCTURAL DRAWINGS ON SITE FOR USE.
 3. SOME LAP LENGTHS WILL BE ROUNDED UP IN DETAILING TO PROVIDE FOR 1" INCREMENTS FOR LAPS.
 4. LAP OR EMBEDMENT LENGTHS SHOWN IN SPECIFIC DETAILS WILL SUPPRESS LAPS IN THE LAP SCHEDULE.
 5. VERIFY PLACEMENT DRAWINGS TO LATEST ISSUE OF JOB RECORD DRAWING FOR POSSIBLE REVISIONS OR FIELD CHANGES.
 6. TYPICAL NOTES & DETAILS ARE USED THROUGHOUT ENTIRE PROJECT & APPLY UNLESS NOTED OTHERWISE.


NO.	REVISION	DESCRIPTION	DATE	BY	CHECKED	L1	L2	L3	L100
JOB NAME:		MALAKOFF HIGH SCHOOL																																																																																																							
JOB NO:		22136																																																																																																							
DETAILS OF:		AREA-D CMU WALL REINFORCEMENT DETAILS															DATE: 11-04-22																																																																																								
DETAILER:		SSSTR															DRWG: M01																																																																																								
		TEXAS REBAR, LLC 817-487-1672																																																																																																							

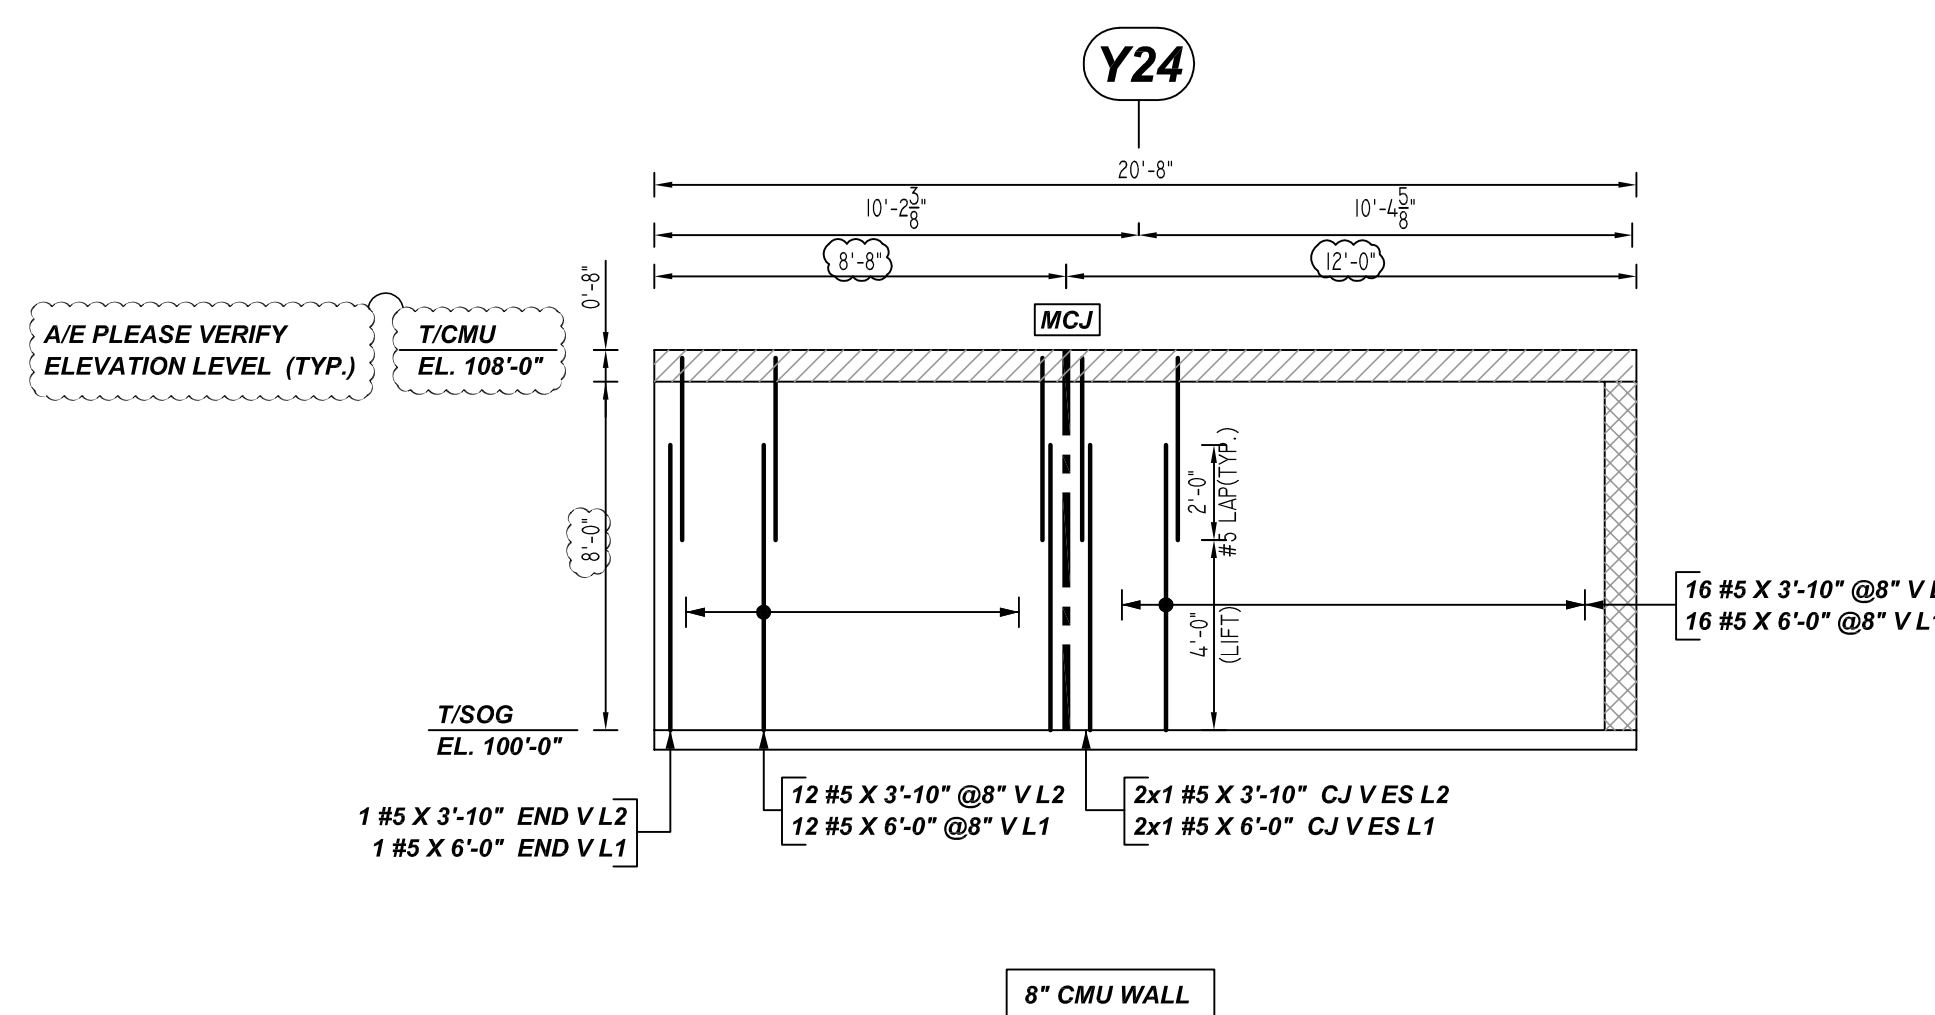


A ELEVATION
 REF: 3.23, 3.03, 3.55 & A4.13
 SCALE: 1/4" = 1'-0"

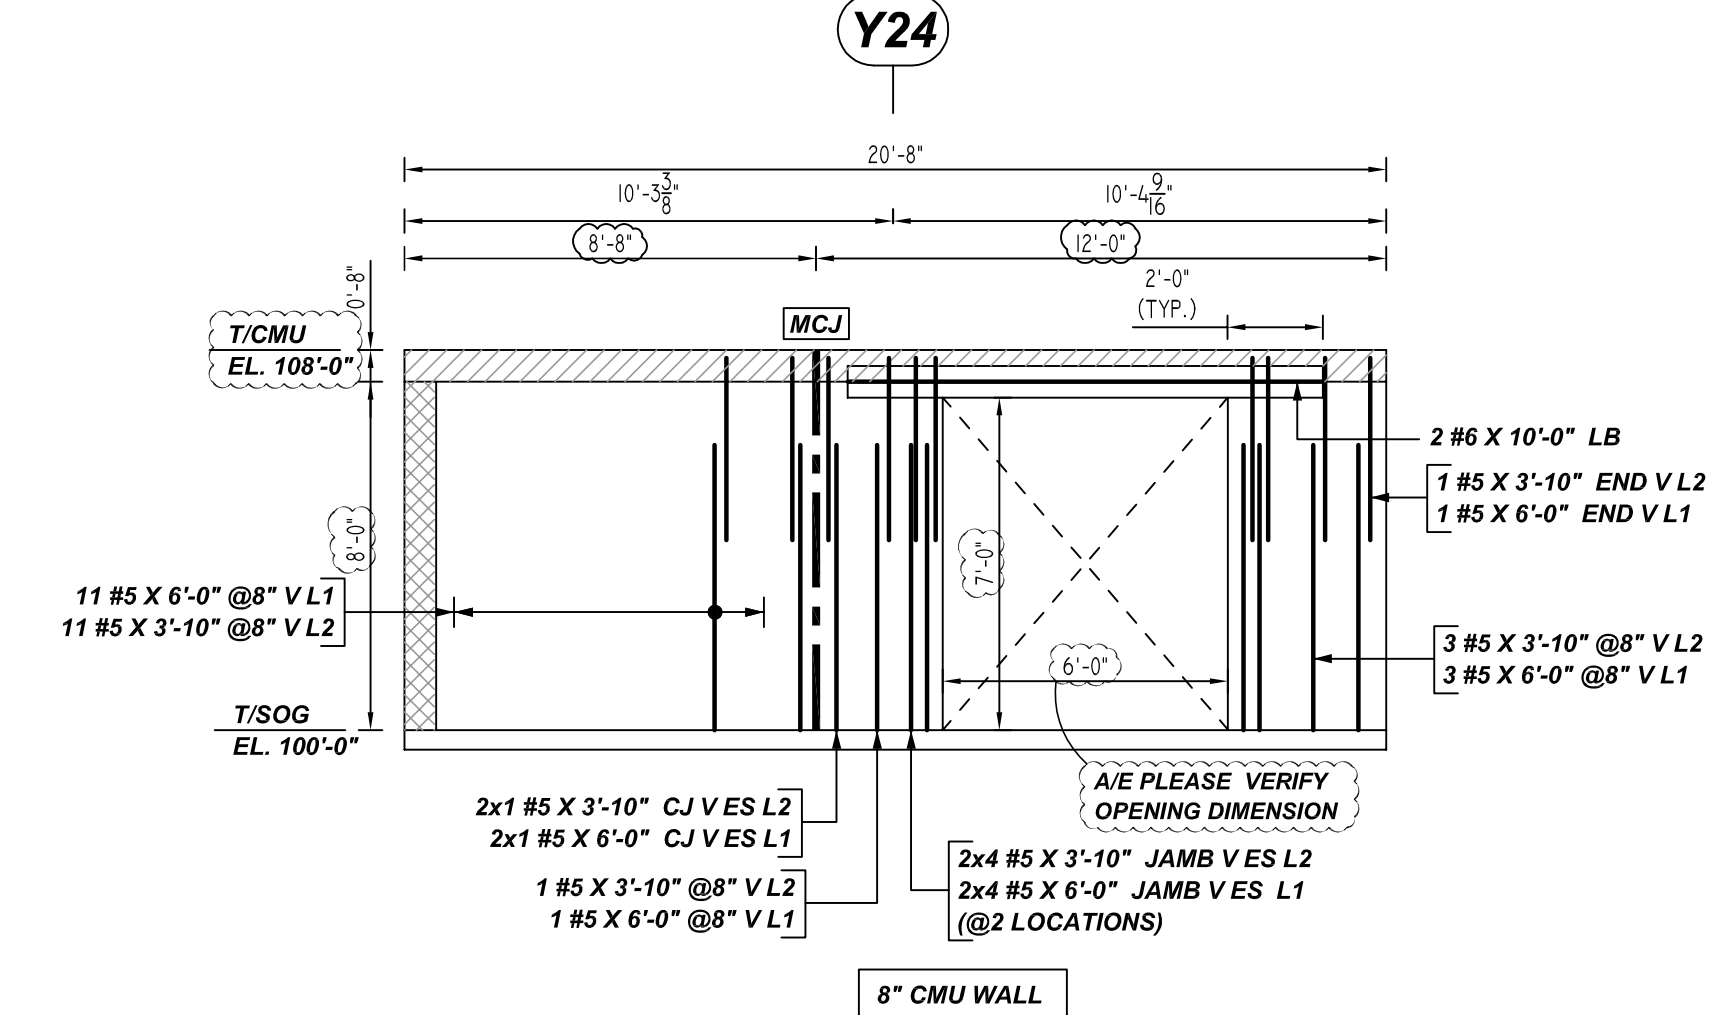

C ELEVATION
 REF: 3.23, 3.03, 3.55 & A4.13
 SCALE: 1/4" = 1'-0"

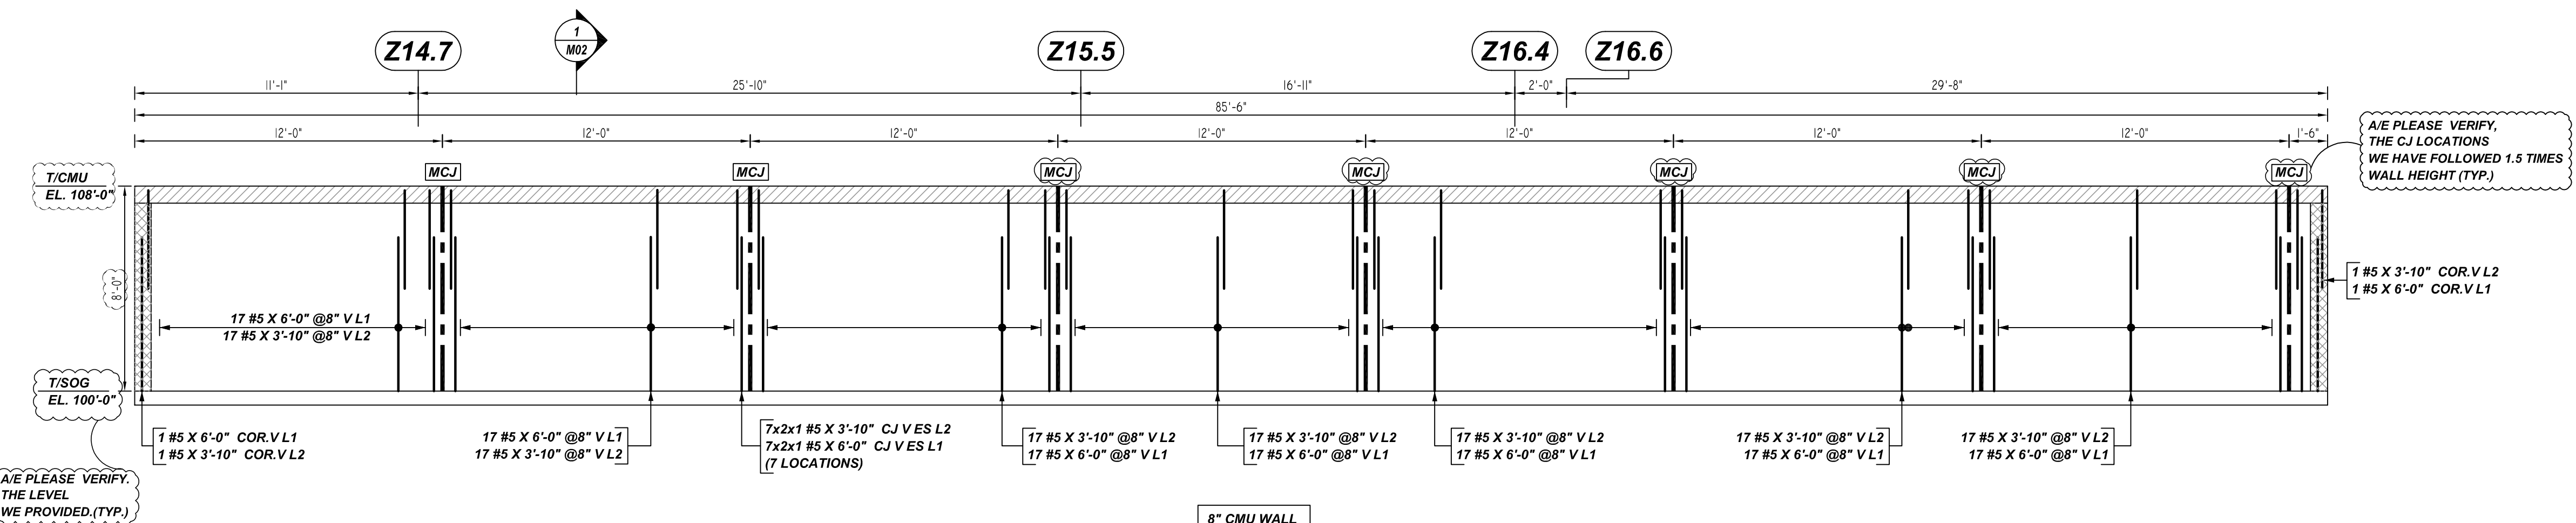


B ELEVATION
 REF: 3.23, 3.03, 3.55 & A4.13
 SCALE: 1/4" = 1'-0"

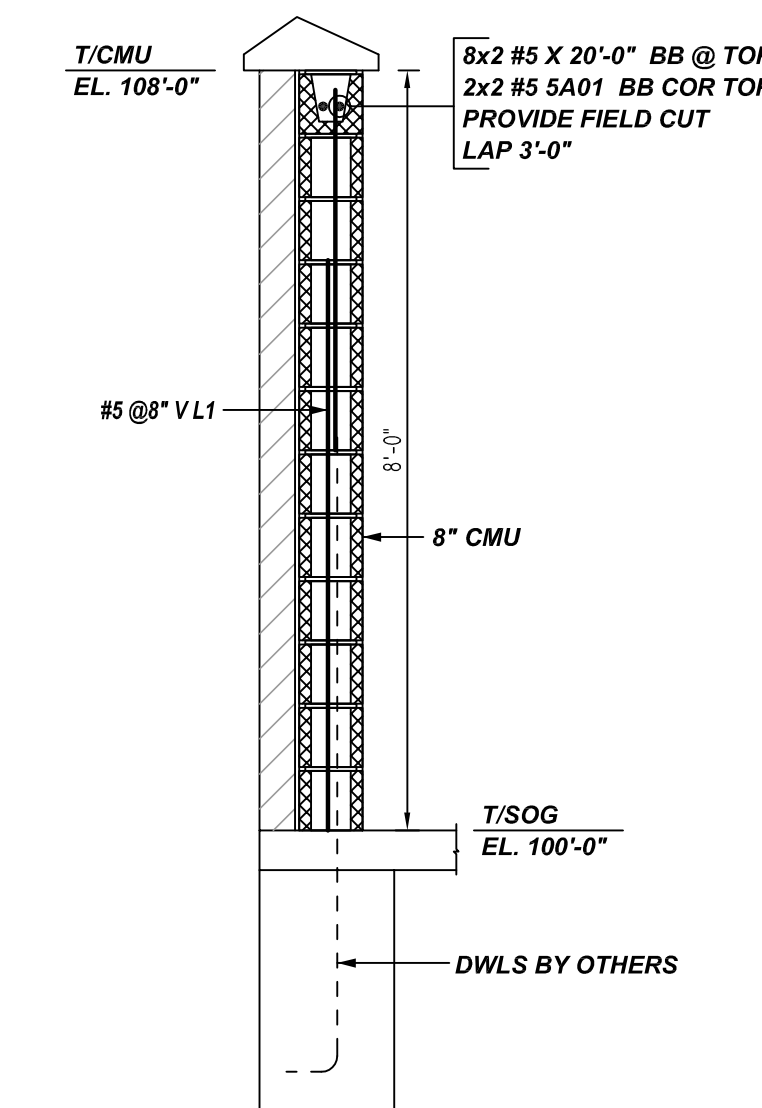

1 SECTION
 REF: 5/3.55
 SCALE: 1/2" = 1'-0"

Rebar Number	M02	BONDING DETAILS																			
Bar No.	Qty	Size	Total Length	Type	X	Y	Z	V	W	X	Y	Z	V	W	X	Y	Z	V	W		
SA01	4	#5	5'-0"	17																	

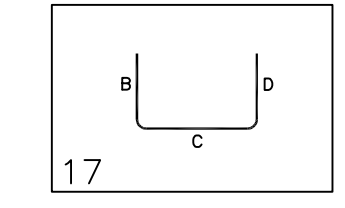

LAP SCHEDULE

BAR#	LENGTHS	
	HORIZONTAL	EACH FACE 8" CMU VERTICAL
#4	2'-0"	1'-6"
#5	3'-0"	2'-0"
#6	5'-4"	3'-8"

**ALL BARS IN THIS DRAWING
 ASTM A615 GRADE 60
 BLACK UNCOATED**

LEGEND

NO. OF LOCATION	NO. OF LIFT	NO. OF BARS
2x3x2	#5x6'-6" VERTS	
NO. OF LIFT (OR) NO. OF LOCATION	NO. OF BARS	
2x1	#5x6'-6" VERTS	
LIFT 1 TO LIFT 6	2x1	#5x6'-6" VERTS L1-L6

- PLACING PLAN NOTES**
- THIS DRAWINGS FOR REBAR PLACEMENT ASSISTANCE ONLY. REFER TO STRUCTURAL DETAILS FOR CONTRACT REQUIREMENTS.
 - SECTIONS & DETAILS DIMENSIONS ON PLACING PLAN ARE FOR REFERENCE AND ARE TO BE USED IN CONJUNCTION WITH CONTRACT DRAWING FOR CRSI MANUAL OF STANDARD PRACTICE.
 - REINFORCING STEEL IS DETAILED PER CONTRACT DOCUMENTS ONLY AS SHOWN. CODE COMPLIANCE REQUIREMENTS ARE THE RESPONSIBILITY OF ENGINEER AND/OR CONTRACTOR.
 - THE CONTRACTOR UNDERSTANDS THAT THE ENGINEER SHOULD ALWAYS VERIFY SHOP DRAWINGS IF TIME DOES NOT ALLOW FOR APPROVALS. TEXAS REBAR IS NOT HELD RESPONSIBLE FOR UNAPPROVED SHOP DRAWINGS USED IN PLACING CRSI MANUAL OF STANDARD PRACTICE. THE CUSTOMER AND ENGINEER SHOULD REVIEW SHOP DRAWINGS PRIOR TO INSTALLATION TO VERIFY ACCURACY TO STRUCTURAL DRAWINGS.
- PLACING PLAN NOTES**
- DIMENSIONS ELEVATIONS & DRAWINGS GRADES SHOWN ARE FOR REFERENCE ONLY. CONTRACTOR TO PROVIDE LINES, GRADES & TEMPLATES REQUIRED FOR PLACEMENTS.
 - SECTIONS & DETAILS MAY NOT BE SHOWN ON ALL PLACING PLANS. KEEP STRUCTURAL DRAWINGS ON SITE FOR USE.
 - SOME LAP LENGTHS WILL BE ROUNDED UP IN DETAILING TO PROVIDE FOR 1" INCREMENTS FOR LAPS.
 - LAP OR EMBEDMENT LENGTHS SHOWN IN SPECIFIC DETAILS WILL SUPPRESS LAPS IN THE LAP SCHEDULE.
 - VERIFY PLACEMENT DRAWINGS TO LATEST ISSUE OF JOB RECORD DRAWING FOR POSSIBLE REVISIONS OR FIELD CHANGES.
 - TYPICAL NOTES & DETAILS ARE USED THROUGHOUT ENTIRE PROJECT & APPLY UNLESS NOTED OTHERWISE.

REVISION	NO.	DATE	DESCRIPTION
	0		FOR APPROVAL
	1		
	2		
	3		
	4		

JOB NAME:	MALAKOFF HIGH SCHOOL
JOB NO:	22136
DETAILS OF:	AREA-D CMU WALL REINFORCEMENT DETAILS
DATE:	11-04-22
DETAILER:	SSSTR
DRWG:	M02
TEXAS REBAR, LLC 817-487-1672	