




A ELEVATION
REF-S-1.1B & S-3.1B
SCALE: 1/4" = 1'-0"

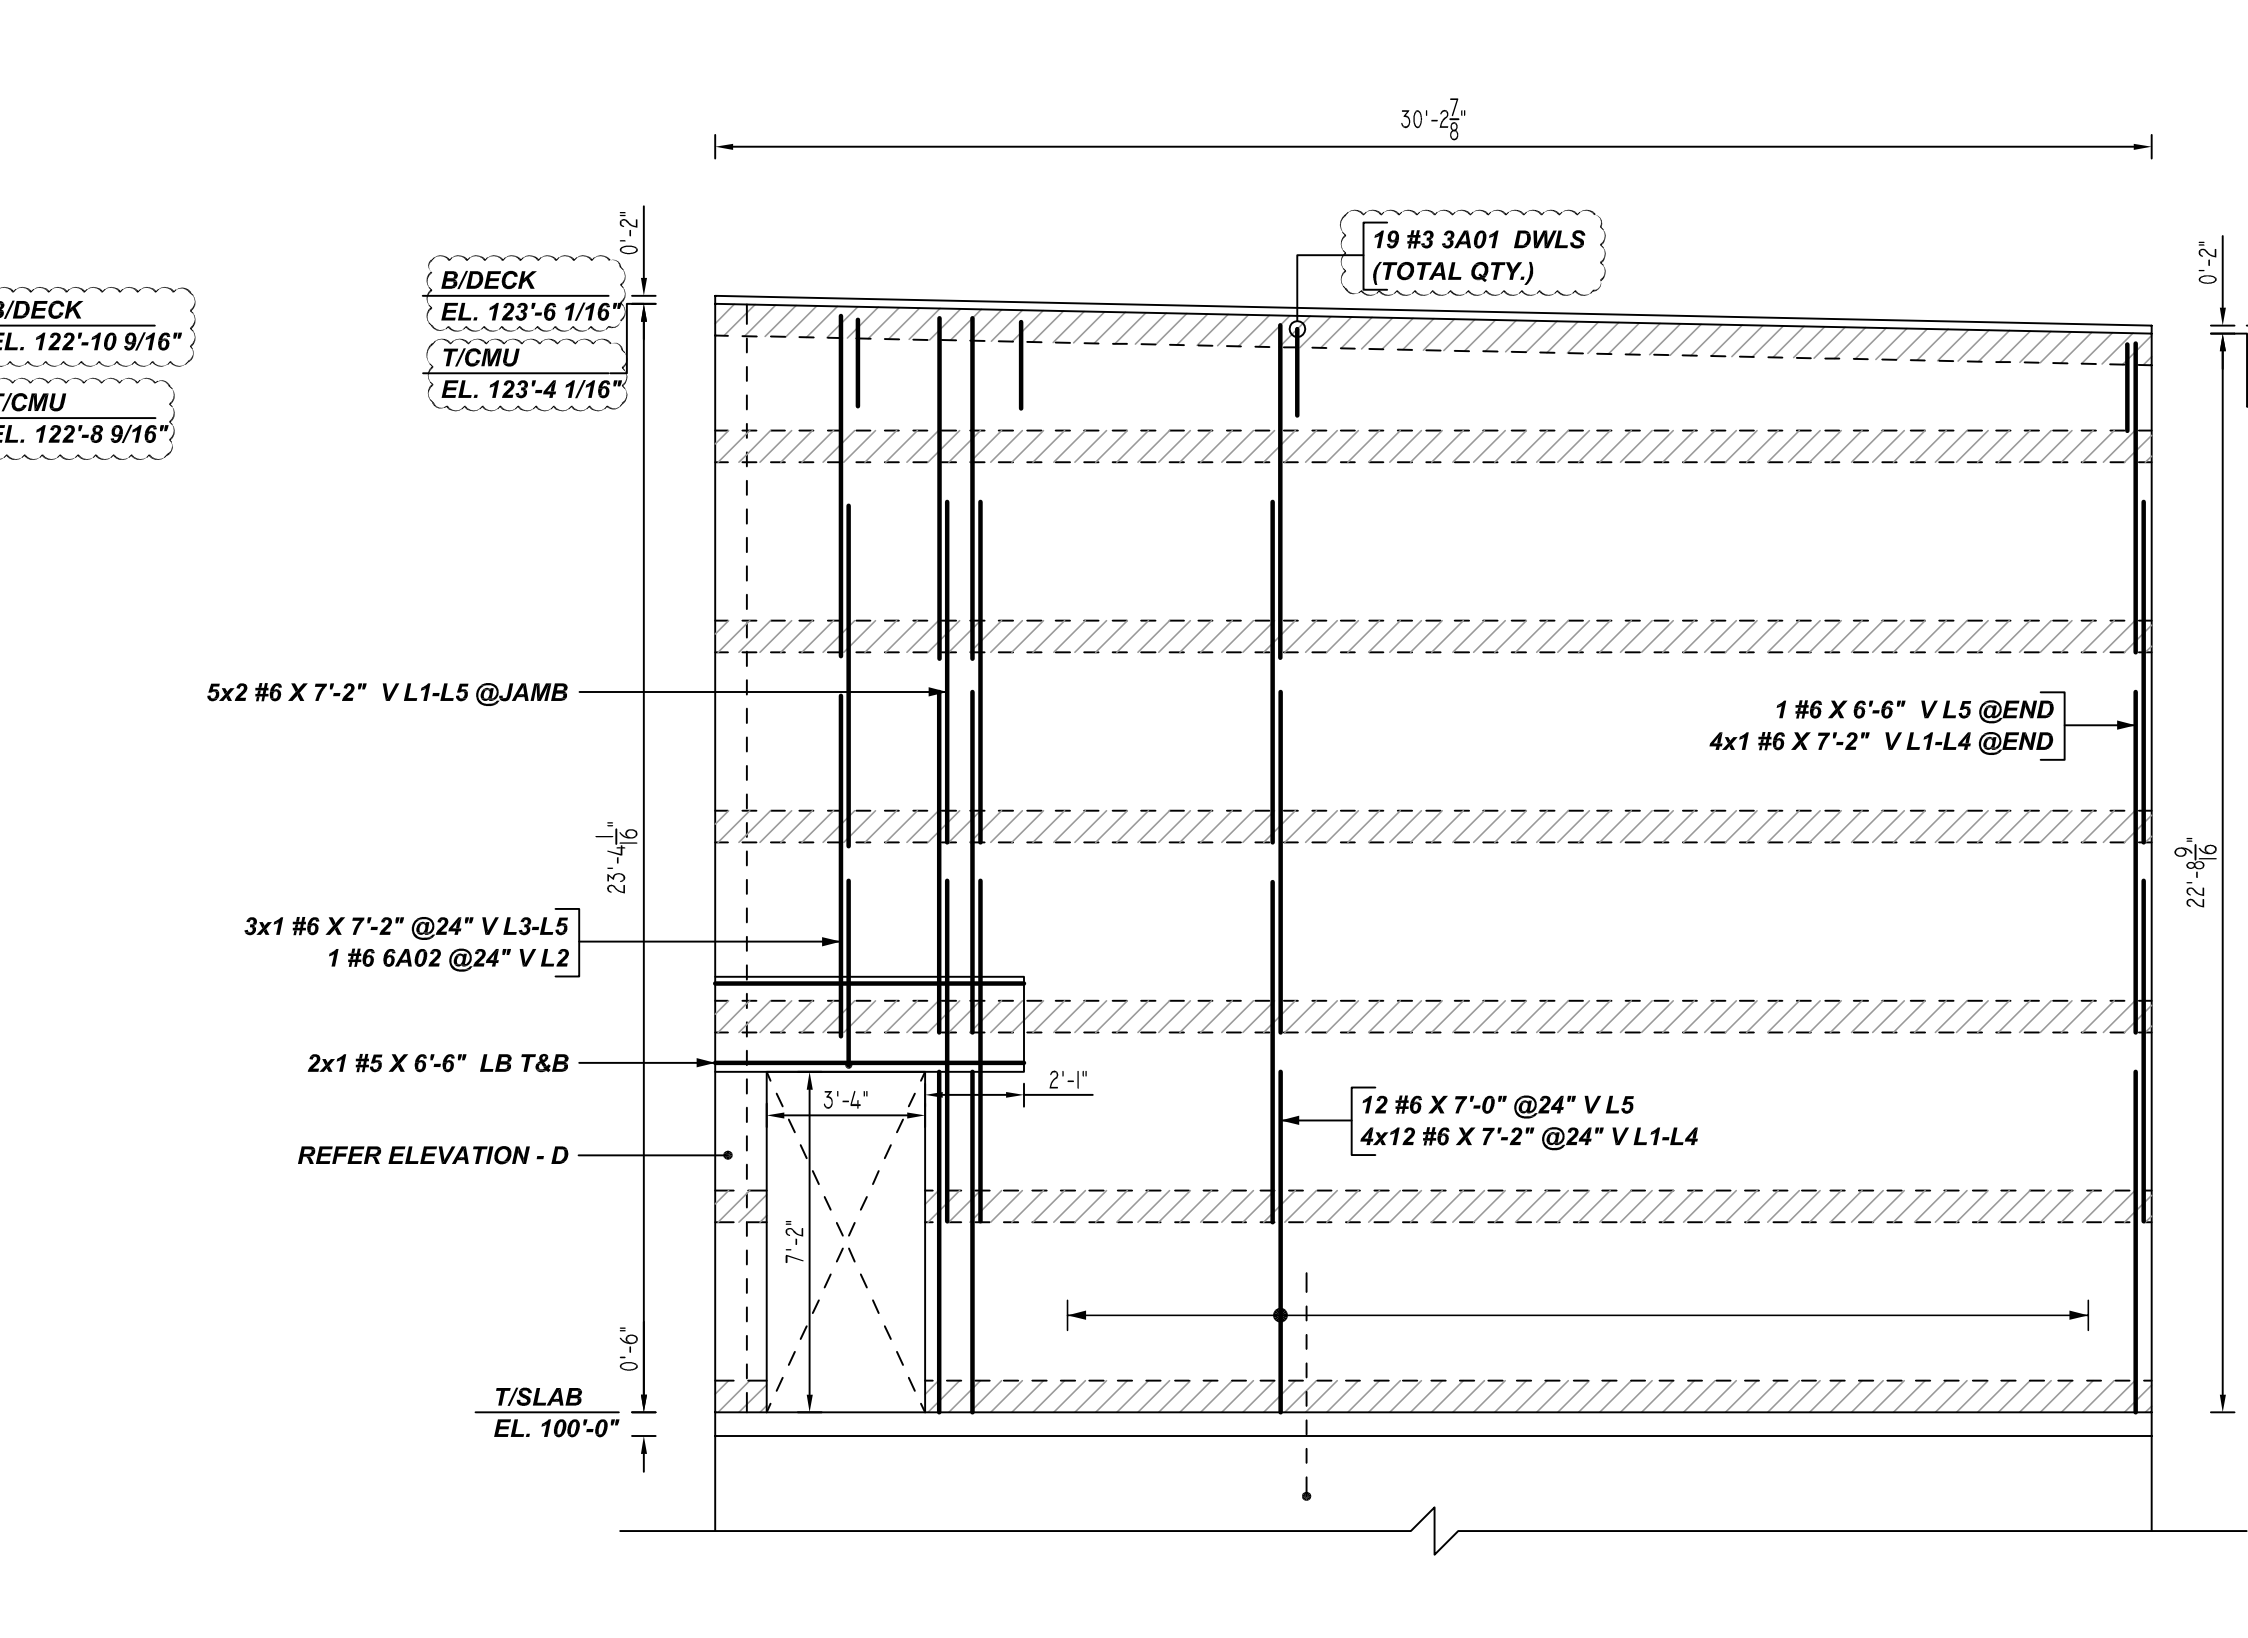


B ELEVATION
REF-S-1.1B & S-3.1B
SCALE: 1/4" = 1'-0"

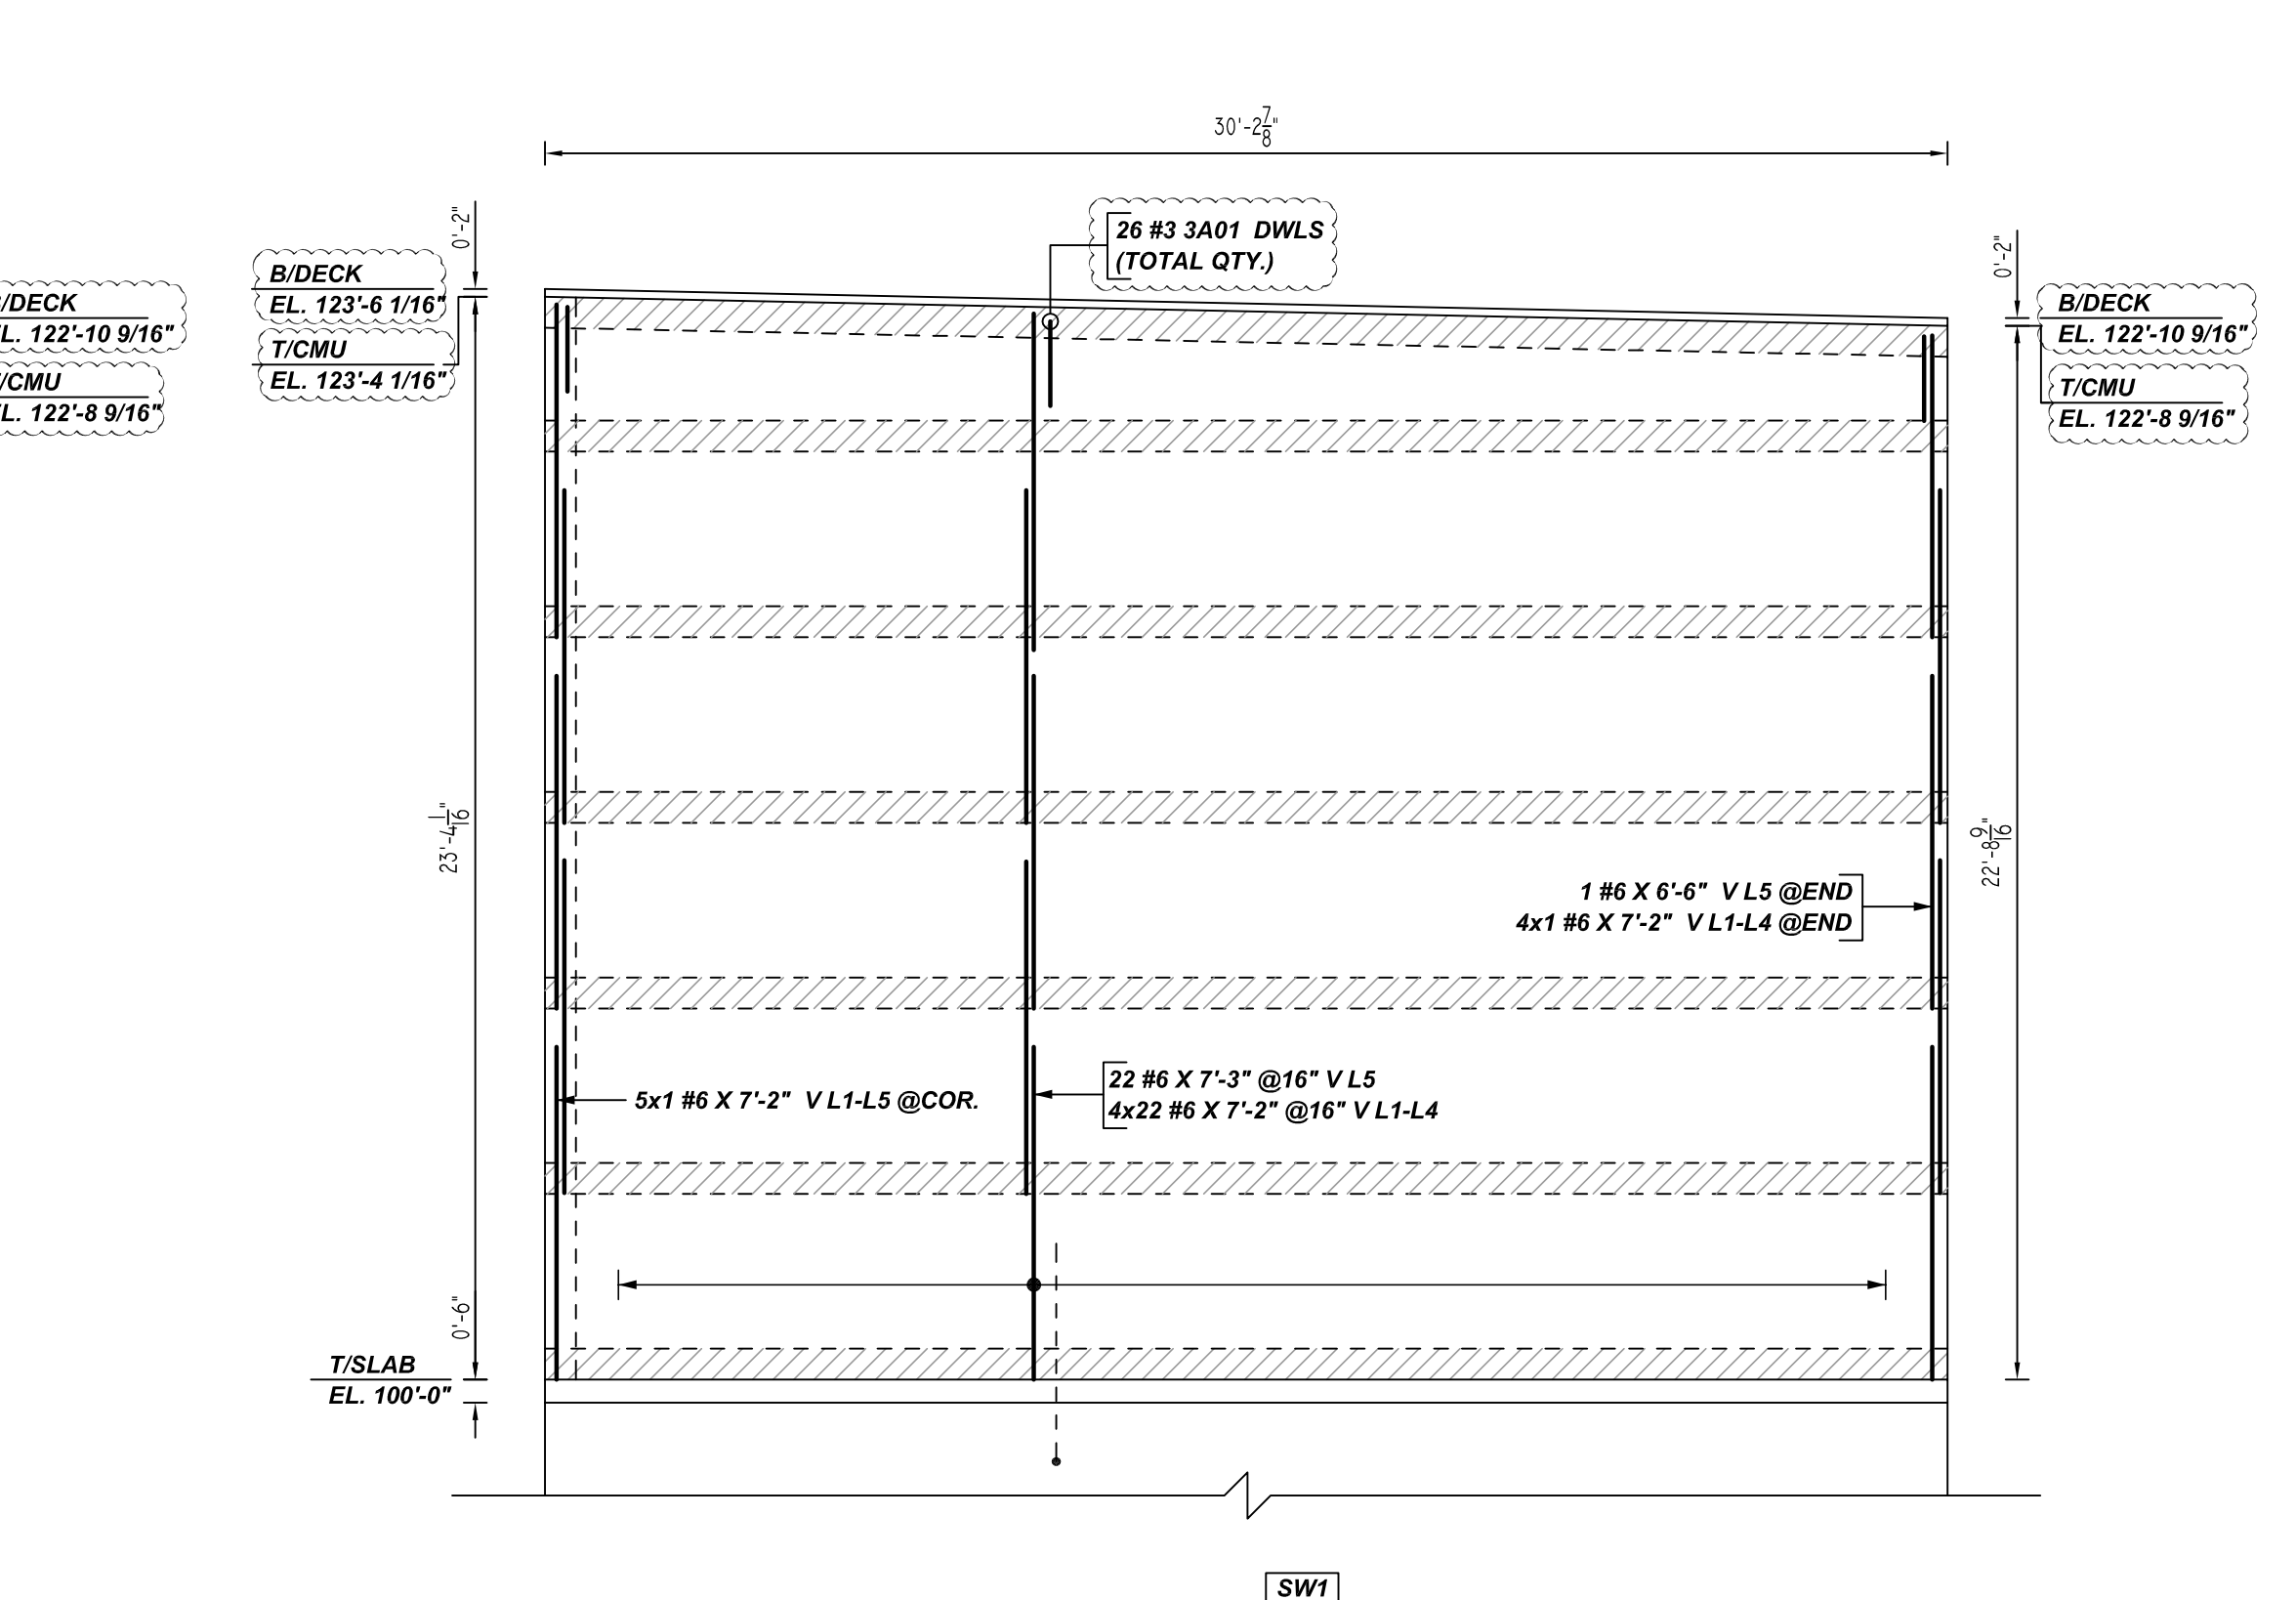

C ELEVATION
REF-S-1.1B & S-3.1B
SCALE: 1/4" = 1'-0"


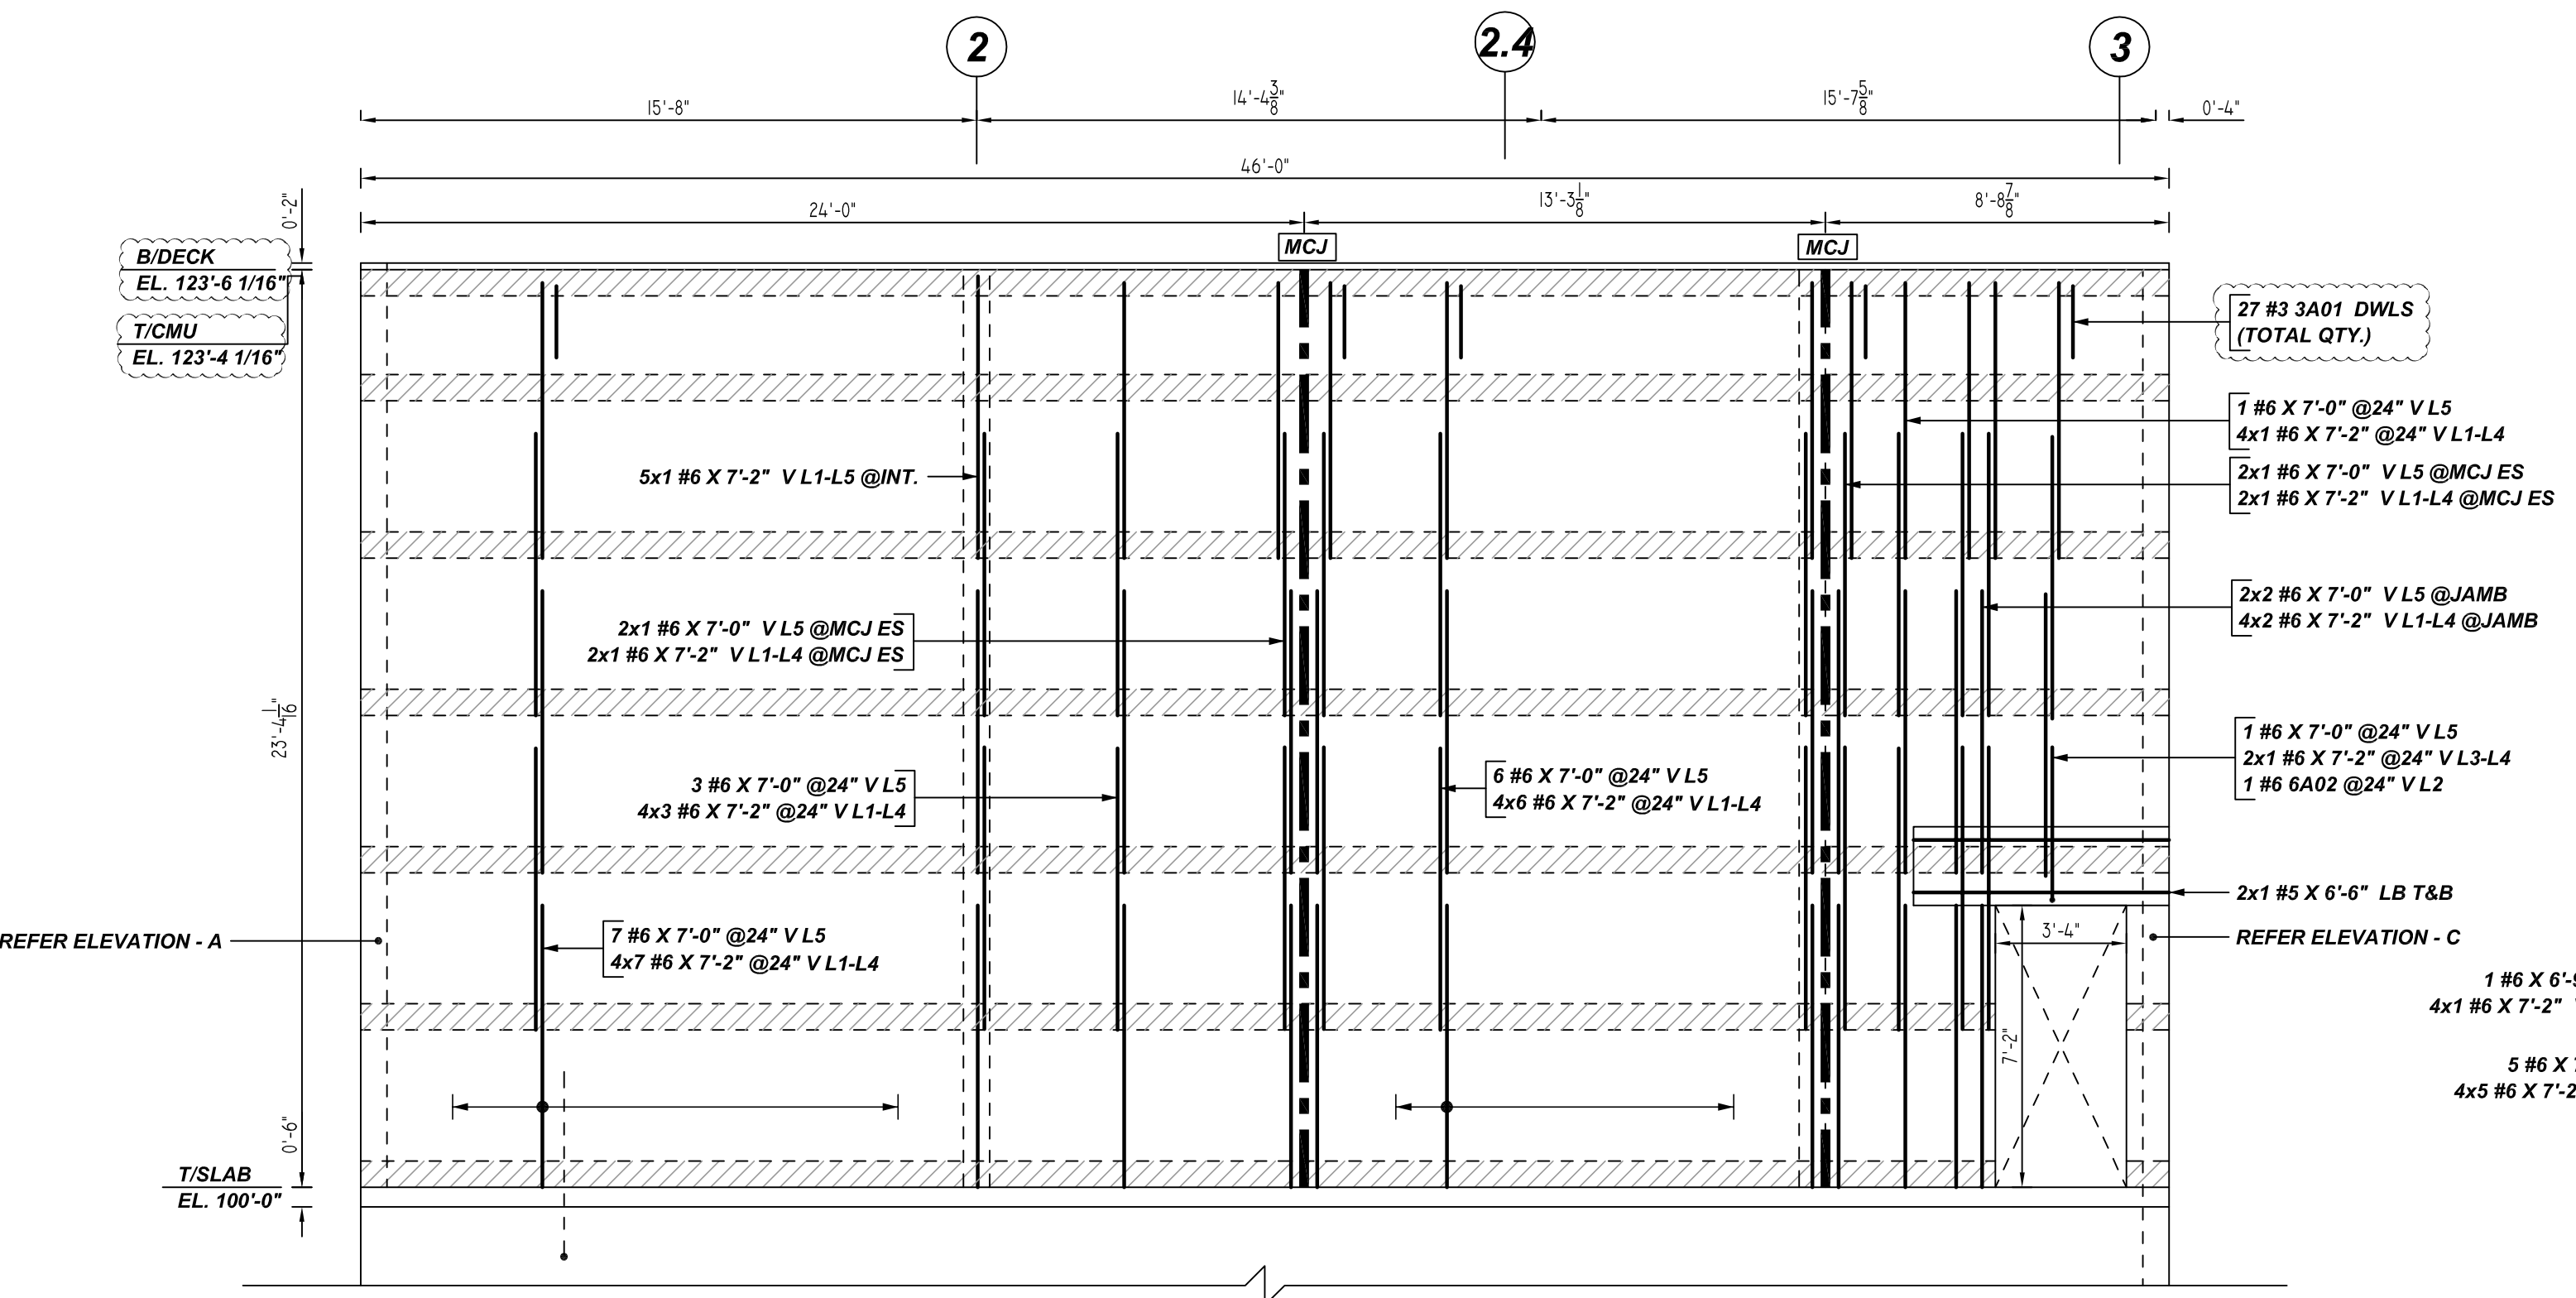


D ELEVATION
REF-S-1.1B & S-3.1B
SCALE: 1/4" = 1'-0"

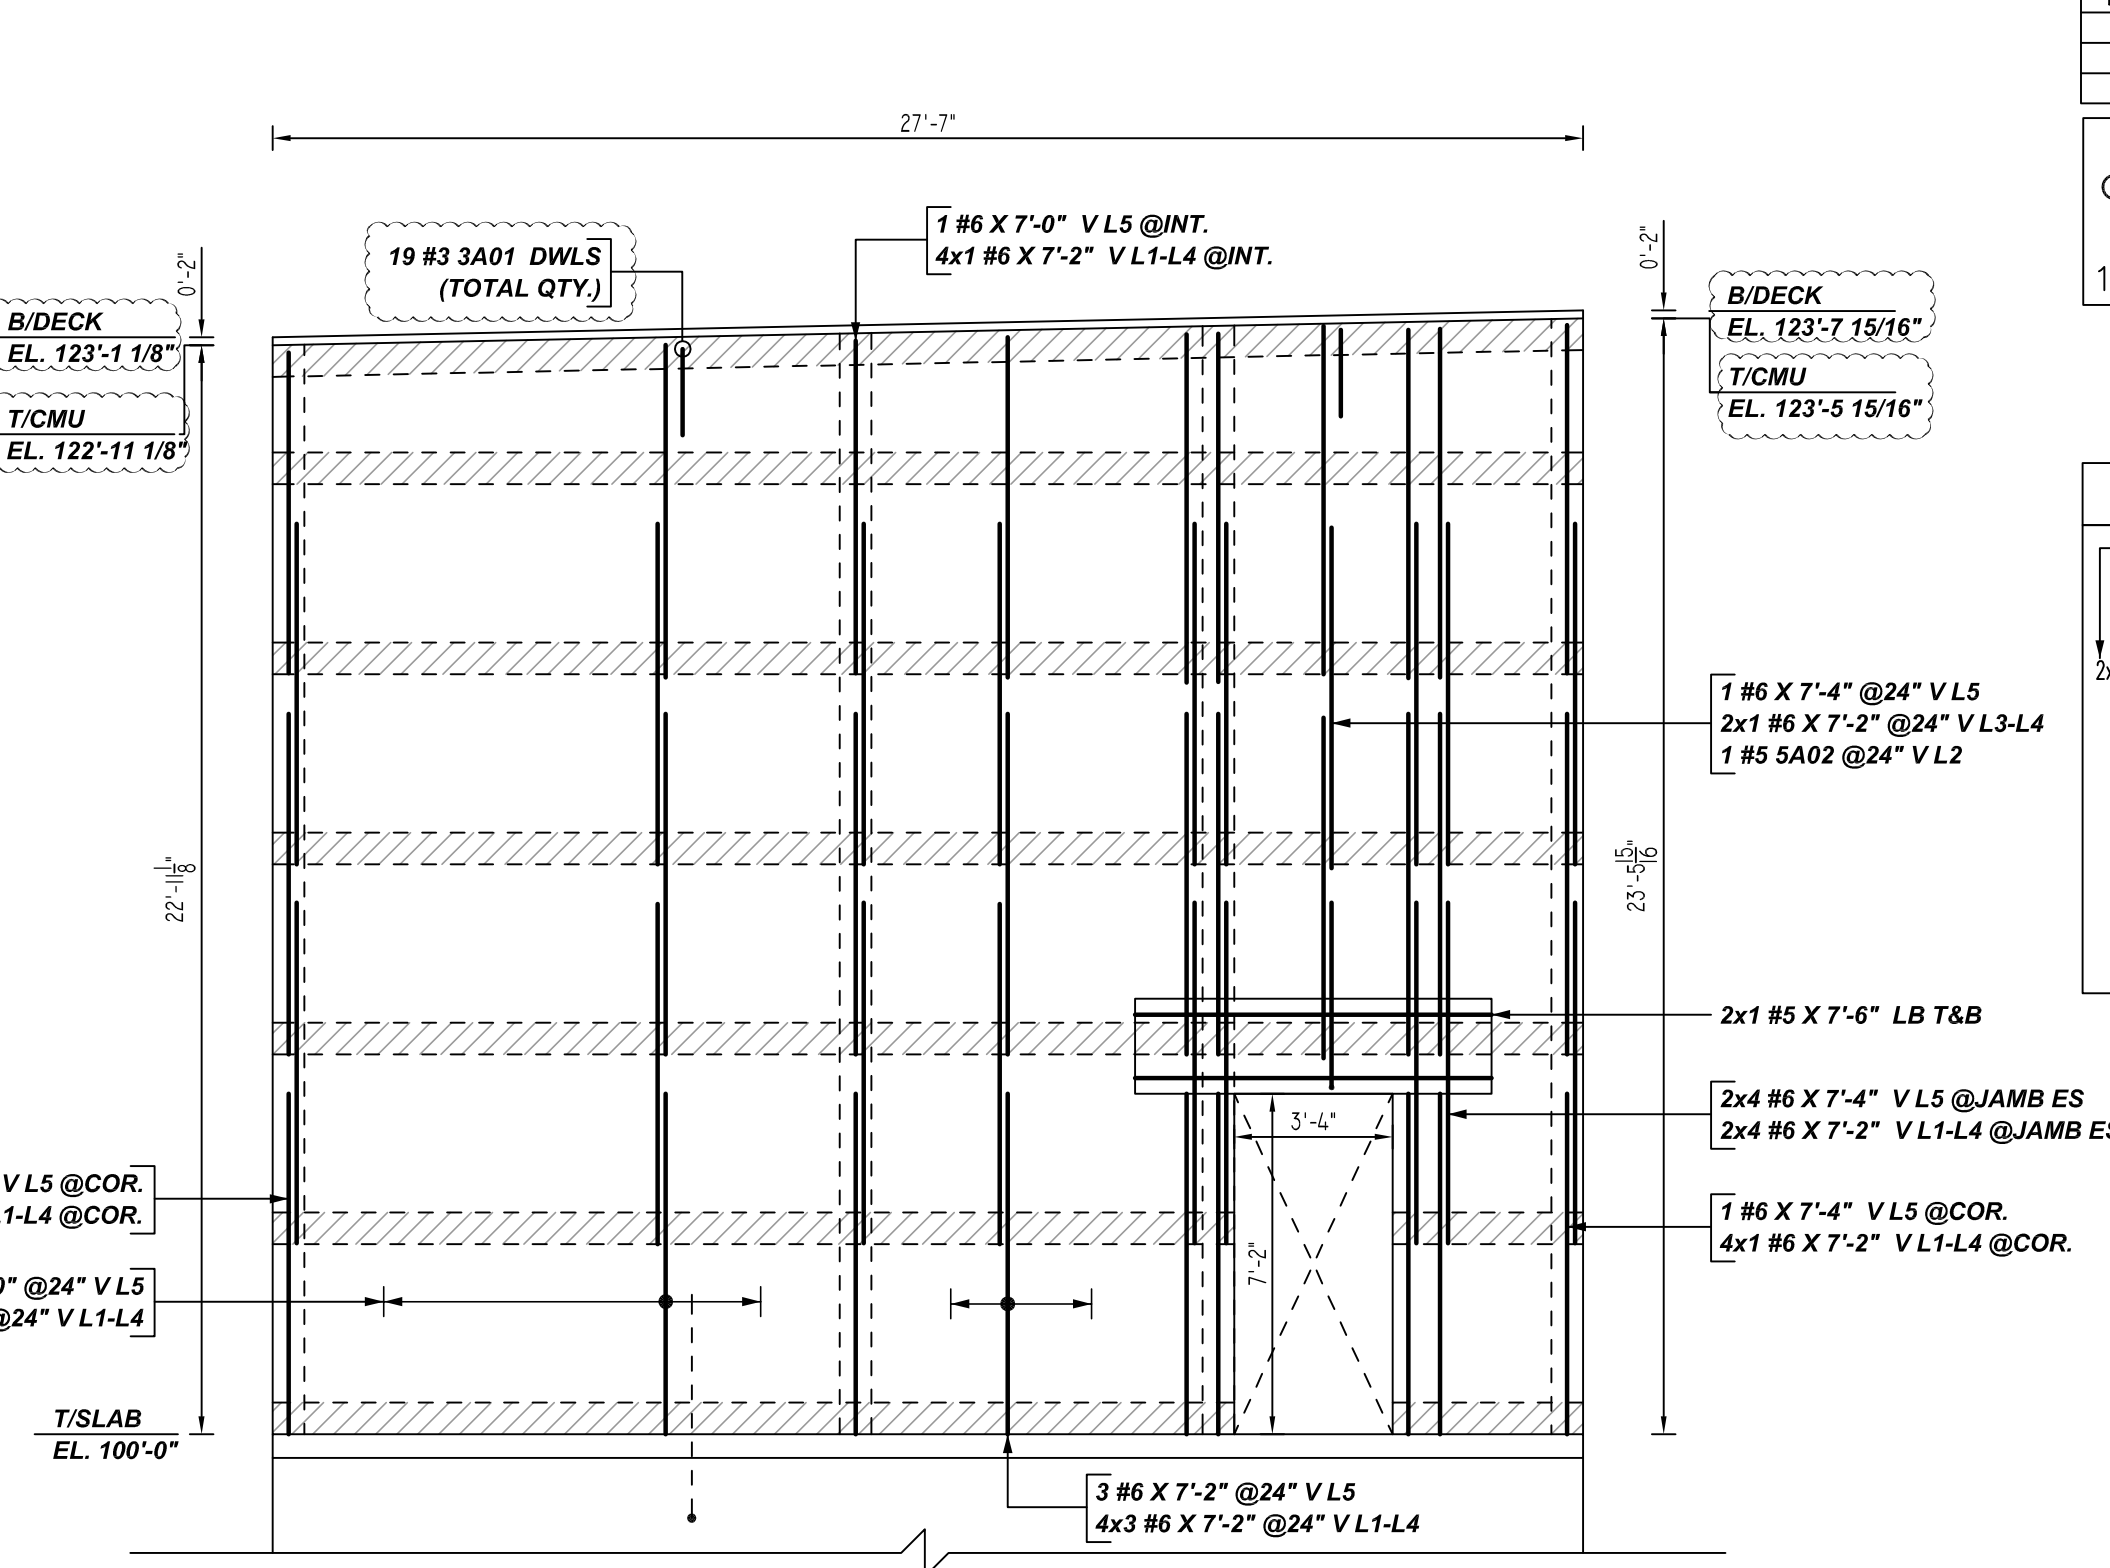

E ELEVATION
REF-S-1.1B & S-3.1B
SCALE: 1/4" = 1'-0"

Bar Mark	Qty	Size	Total Length	Type	X	Y	Z	W	V	U	T	S	R	Q	P	O	N	M	L	K	J	I	H	G	F	E	D	C	B	A
3A01	108	#3	2'-3"	1	0'-5"	1'-10"																								
5A02	1	#5	4'-9"	2	0'-10"	3'-11"																								
6A02	2	#5	4'-11"	2	1'-0"	3'-11"																								

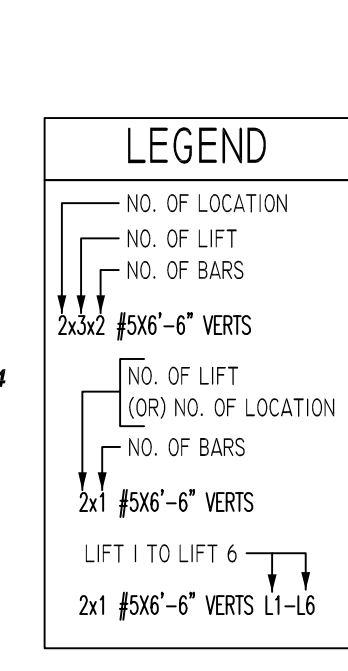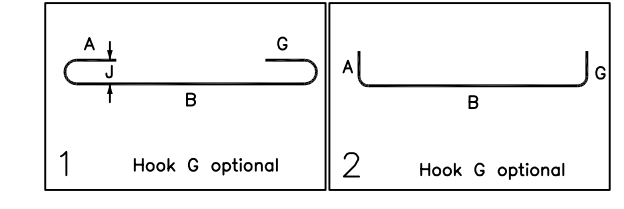

LAP SCHEDULE

LAP SPLICE SCHEDULE

BAR SIZE	LAP
#3	1'-10"
#4	2'-3"
#5	2'-8"
#6	3'-2"
#7	3'-9"
#8	4'-9"
#9	6'-1"

TYPICAL REINFORCING BAR CLEARANCE TABLE

LOCATION	MIN. COVER
CMU WALL TOP	2" CLR


ALL BARS IN THIS DRAWING
ASTM A615 GRADE 60
BLACK UNCOATED

- PLACING PLAN NOTES**
- THIS DRAWINGS FOR REBAR PLACEMENT ASSISTANCE ONLY. REFER TO STRUCTURAL DETAILS FOR CONTRACT REQUIREMENTS.
 - SECTIONS & DETAILS DIMENSIONS ON PLACING PLAN ARE FOR REFERENCE AND ARE TO BE USED IN CONJUNCTION WITH CONTRACT DRAWINGS FOR CSRI MANUAL OF STANDARD PRACTICE.
 - REINFORCING STEEL IS DETAILED PER CONTRACT DOCUMENTS ONLY AS SHOWN. CODE COMPLIANCE REQUIREMENTS ARE THE RESPONSIBILITY OF ENGINEER AND/OR CONTRACTOR.
 - THE CONTRACTOR UNDERSTANDS THAT THE ENGINEER SHOULD ALWAYS VERIFY SHOP DRAWINGS IF TIME DOES NOT ALLOW FOR APPROVALS. TEXAS REBAR IS NOT HELD RESPONSIBLE FOR UNAPPROVED SHOP DRAWINGS USED IN PLACING CSRI MANUAL OF STANDARD PRACTICE. THE CUSTOMER AND ENGINEER SHOULD REVIEW SHOP DRAWINGS PRIOR TO INSTALLATION TO VERIFY ACCURACY TO STRUCTURAL DRAWINGS.

- PLACING PLAN NOTES**
- DIMENSIONS ELEVATIONS & DRAWINGS SCALES SHOWN ARE FOR REFERENCE ONLY. CONTRACTOR TO PROVIDE LINES, GRADES & TEMPLATES REQUIRED FOR PLACEMENTS.
 - SECTIONS & DETAILS MAY NOT BE SHOWN ON ALL PLACING PLANS. KEEP STRUCTURAL DRAWINGS ON SITE FOR USE.
 - SOME LAP LENGTHS WILL BE ROUNDED UP IN DETAILING TO PROVIDE FOR 1" INCREMENTS FOR LAPS.
 - LAP ON EMBEDMENT LENGTHS SHOWN IN SPECIFIC DETAILS WILL SUPPRESS LAPS IN THE LAP SCHEDULE.
 - VERIFY PLACEMENT DRAWINGS TO LATEST ISSUE OF JOB RECORD DRAWING FOR POSSIBLE REVISIONS OR FIELD CHANGES.
 - TYPICAL NOTES & DETAILS ARE USED THROUGHOUT ENTIRE PROJECT & APPLY UNLESS NOTED OTHERWISE.

NO.	DATE	DESCRIPTION	BY	CHKD
1	11-08-22	ISSUED		
2				
3				
4				

JOB NAME: CDRJ MC KINNEY
 JOB NO: 22139
 DETAILS OF: AREA-B CMU WALL REINFORCEMENT DETAILS
 DATE: 11-08-22
 DETAILER: SSSTR
 DRWG: M02
 TEXAS REBAR, LLC 817-487-1672

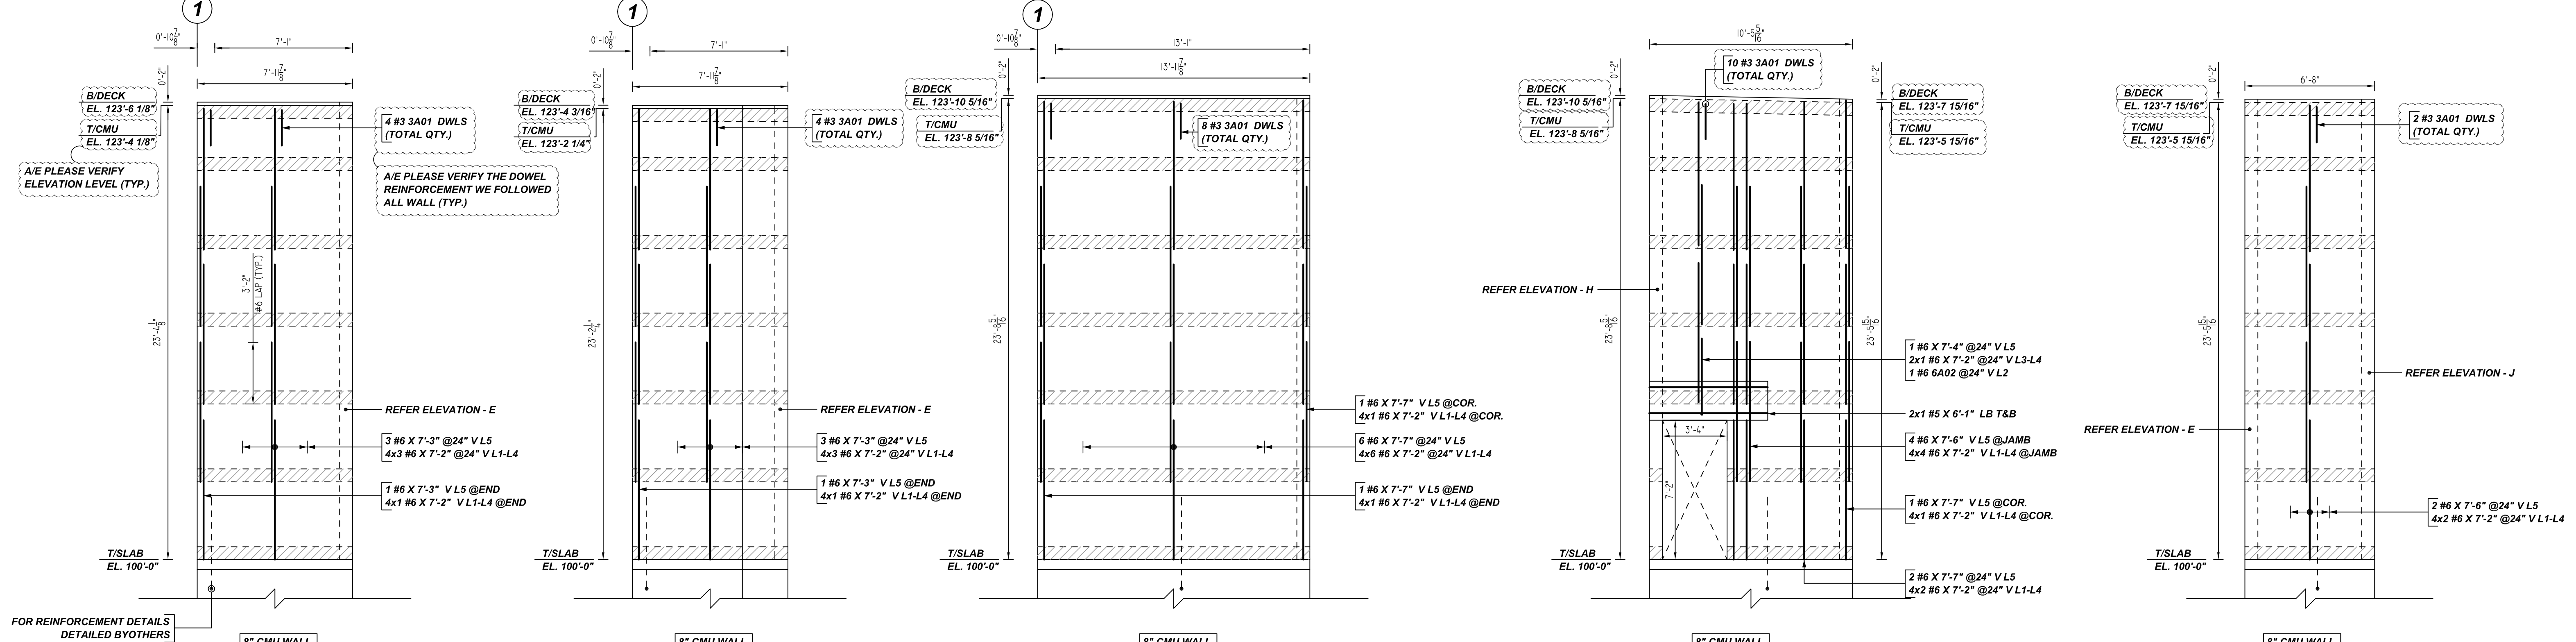


F ELEVATION
REF: S-1.1B & S-3.1B
SCALE: 1/4" = 1'-0"

G ELEVATION
REF: S-1.1B & S-3.1B
SCALE: 1/4" = 1'-0"

H ELEVATION
REF: S-1.1B & S-3.1B
SCALE: 1/4" = 1'-0"

J ELEVATION
REF: S-1.1B & S-3.1B
SCALE: 1/4" = 1'-0"

K ELEVATION
REF: S-1.1B & S-3.1B
SCALE: 1/4" = 1'-0"

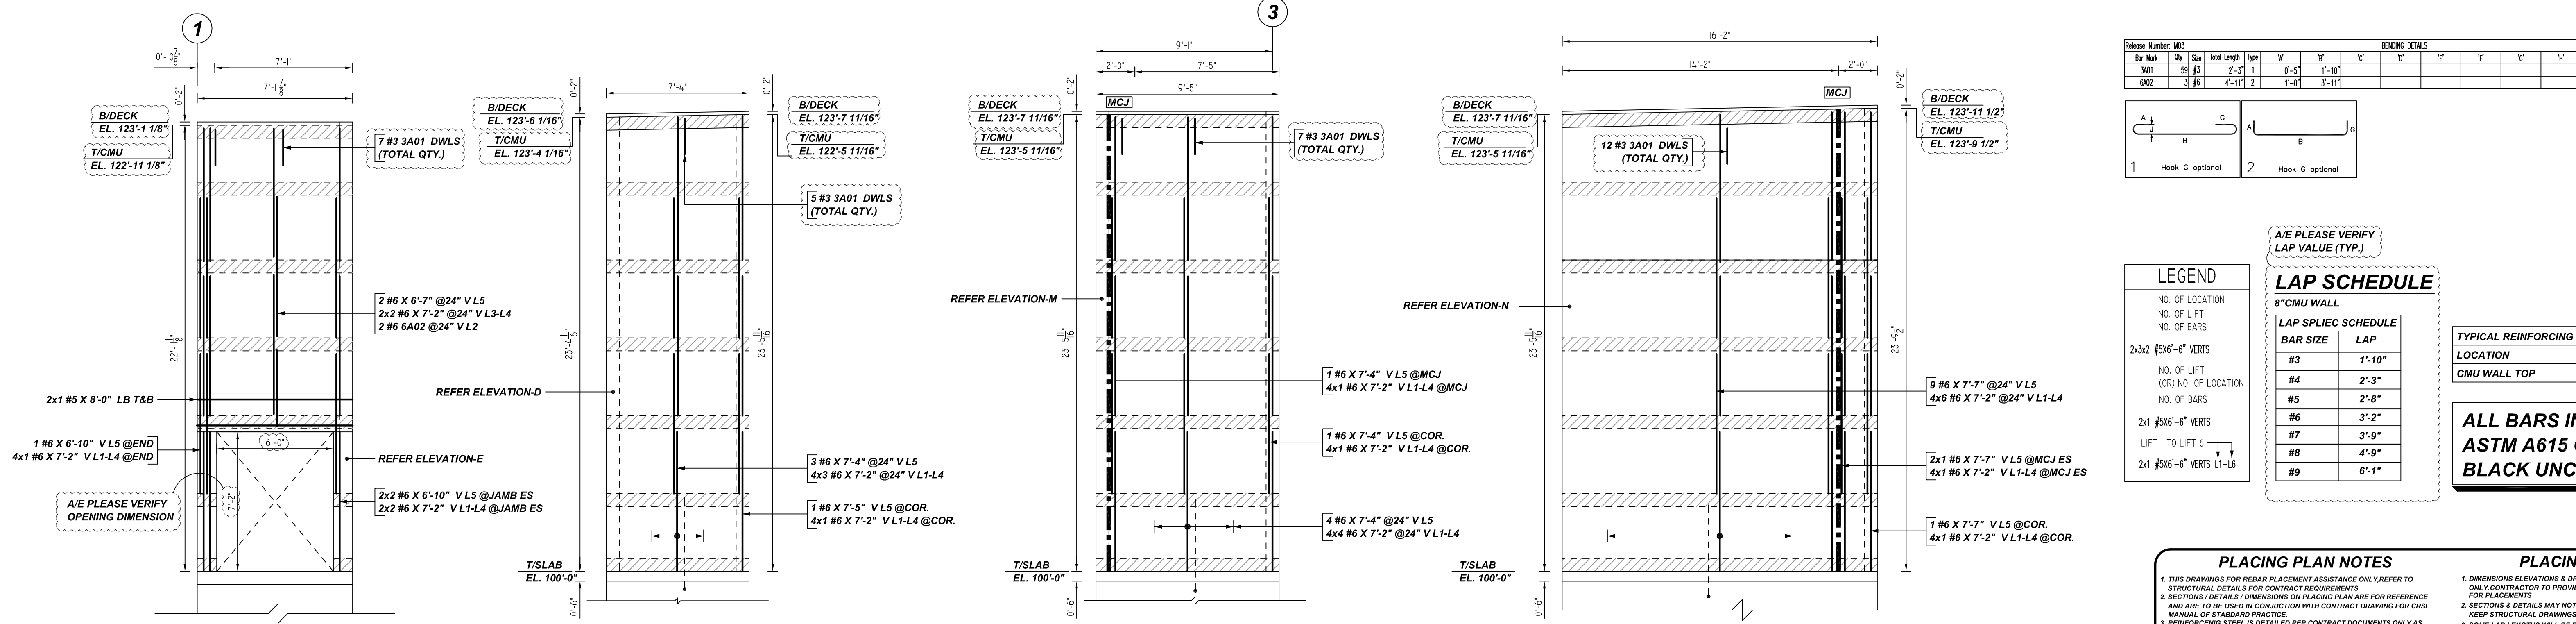


L ELEVATION
REF: S-1.1B & S-3.1B
SCALE: 1/4" = 1'-0"

M ELEVATION
REF: S-3.1B
SCALE: 1/4" = 1'-0"

N ELEVATION
REF: S-3.1B
SCALE: 1/4" = 1'-0"

P ELEVATION
REF: S-3.1B
SCALE: 1/4" = 1'-0"

Bar Mark	Qty	Size	Total Length	Type	X	Y	Z	W	V	U	T	S	R	Q	P	O	N	M	L	K	J	I	H	G	F	E	D	C	B	A
3A01	59	#3	2'-3"	1	0'-5"	1'-10"																								
6A02	3	#6	4'-11"	2	1'-0"	3'-11"																								

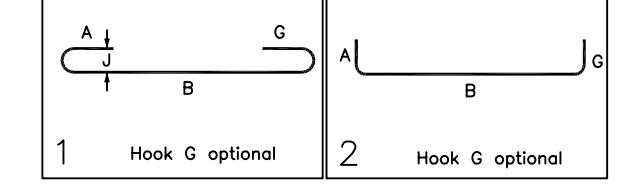

LEGEND

NO. OF LOCATION
NO. OF LIFT
NO. OF BARS

2x32 #5X6'-6" VERTS

NO. OF LIFT
(OR) NO. OF LOCATION
NO. OF BARS

2x1 #5X6'-6" VERTS
LIFT 1 TO LIFT 6
2x1 #5X6'-6" VERTS L1-L6

LAP SCHEDULE

8" CMU WALL

BAR SIZE	LAP
#3	1'-10"
#4	2'-3"
#5	2'-8"
#6	3'-2"
#7	3'-9"
#8	4'-9"
#9	6'-1"

TYPICAL REINFORCING BAR CLEARANCE TABLE

LOCATION	MIN. COVER
CMU WALL TOP	2" CLR


**ALL BARS IN THIS DRAWING
ASTM A615 GRADE 60
BLACK UNCOATED**

- PLACING PLAN NOTES**
- THIS DRAWINGS FOR REBAR PLACEMENT ASSISTANCE ONLY. REFER TO STRUCTURAL DETAILS FOR CONTRACT REQUIREMENTS.
 - SECTIONS & DETAILS IN DIMENSIONS ON PLACING PLAN ARE FOR REFERENCE AND ARE TO BE USED IN CONJUNCTION WITH CONTRACT DRAWING FOR CRSI MANUAL OF STANDARD PRACTICE.
 - REINFORCING STEEL IS DETAILED PER CONTRACT DOCUMENTS ONLY AS SHOWN CODE COMPLIANCE REQUIREMENTS ARE THE RESPONSIBILITY OF ENGINEER AND/OR CONTRACTOR.
 - THE CONTRACTOR UNDERSTANDS THAT THE ENGINEER SHOULD ALWAYS VERIFY SHOP DRAWINGS IF TIME DOES NOT ALLOW FOR APPROVALS. TEXAS REBAR IS NOT HELD RESPONSIBLE FOR UNAPPROVED SHOP DRAWINGS USED IN PLACING CRSI MANUAL OF STANDARD PRACTICE THE CUSTOMER AND ENGINEER SHOULD REVIEW SHOP DRAWINGS PRIOR TO INSTALLATION TO VERIFY ACCURACY TO STRUCTURAL DRAWINGS.
- PLACING PLAN NOTES**
- DIMENSIONS ELEVATIONS & DRAWINGS SCALES SHOWN ARE FOR REFERENCE ONLY. CONTRACTOR TO PROVIDE LINES, GRADES & TEMPLATES REQUIRED FOR PLACEMENTS.
 - SECTIONS & DETAILS MAY NOT BE SHOWN ON ALL PLACING PLANS. KEEP STRUCTURAL DRAWINGS ON SITE FOR USE.
 - SOME LAP LENGTHS WILL BE ROUNDED UP IN DETAILING TO PROVIDE FOR 1" INCREMENTS FOR LAPS.
 - LAP OR EMBEDMENT LENGTHS SHOWN IN SPECIFIC DETAILS WILL SUPPRESS LAPS IN THE LAP SCHEDULE.
 - VERIFY PLACEMENT DRAWINGS TO LATEST ISSUE OF JOB RECORD DRAWING FOR POSSIBLE REVISIONS OR FIELD CHANGES.
 - TYPICAL NOTES & DETAILS ARE USED THROUGHOUT ENTIRE PROJECT & APPLY UNLESS NOTED OTHERWISE.


REVISION	NO.	DESCRIPTION	DATE
FOR APPROVAL	1		11-08-22
	2		
	3		
	4		

MADE BY: []
DATE: []
CHECKED BY: []
DATE: []


JOB NAME: CDRJ MC KINNEY
JOB NO: 22139
DETAILS OF: AREA-B CMU WALL REINFORCEMENT DETAILS
DATE: 11-08-22
DETAILER: SSSTR
DRWG: M03
TEXAS REBAR, LLC 817-487-1672

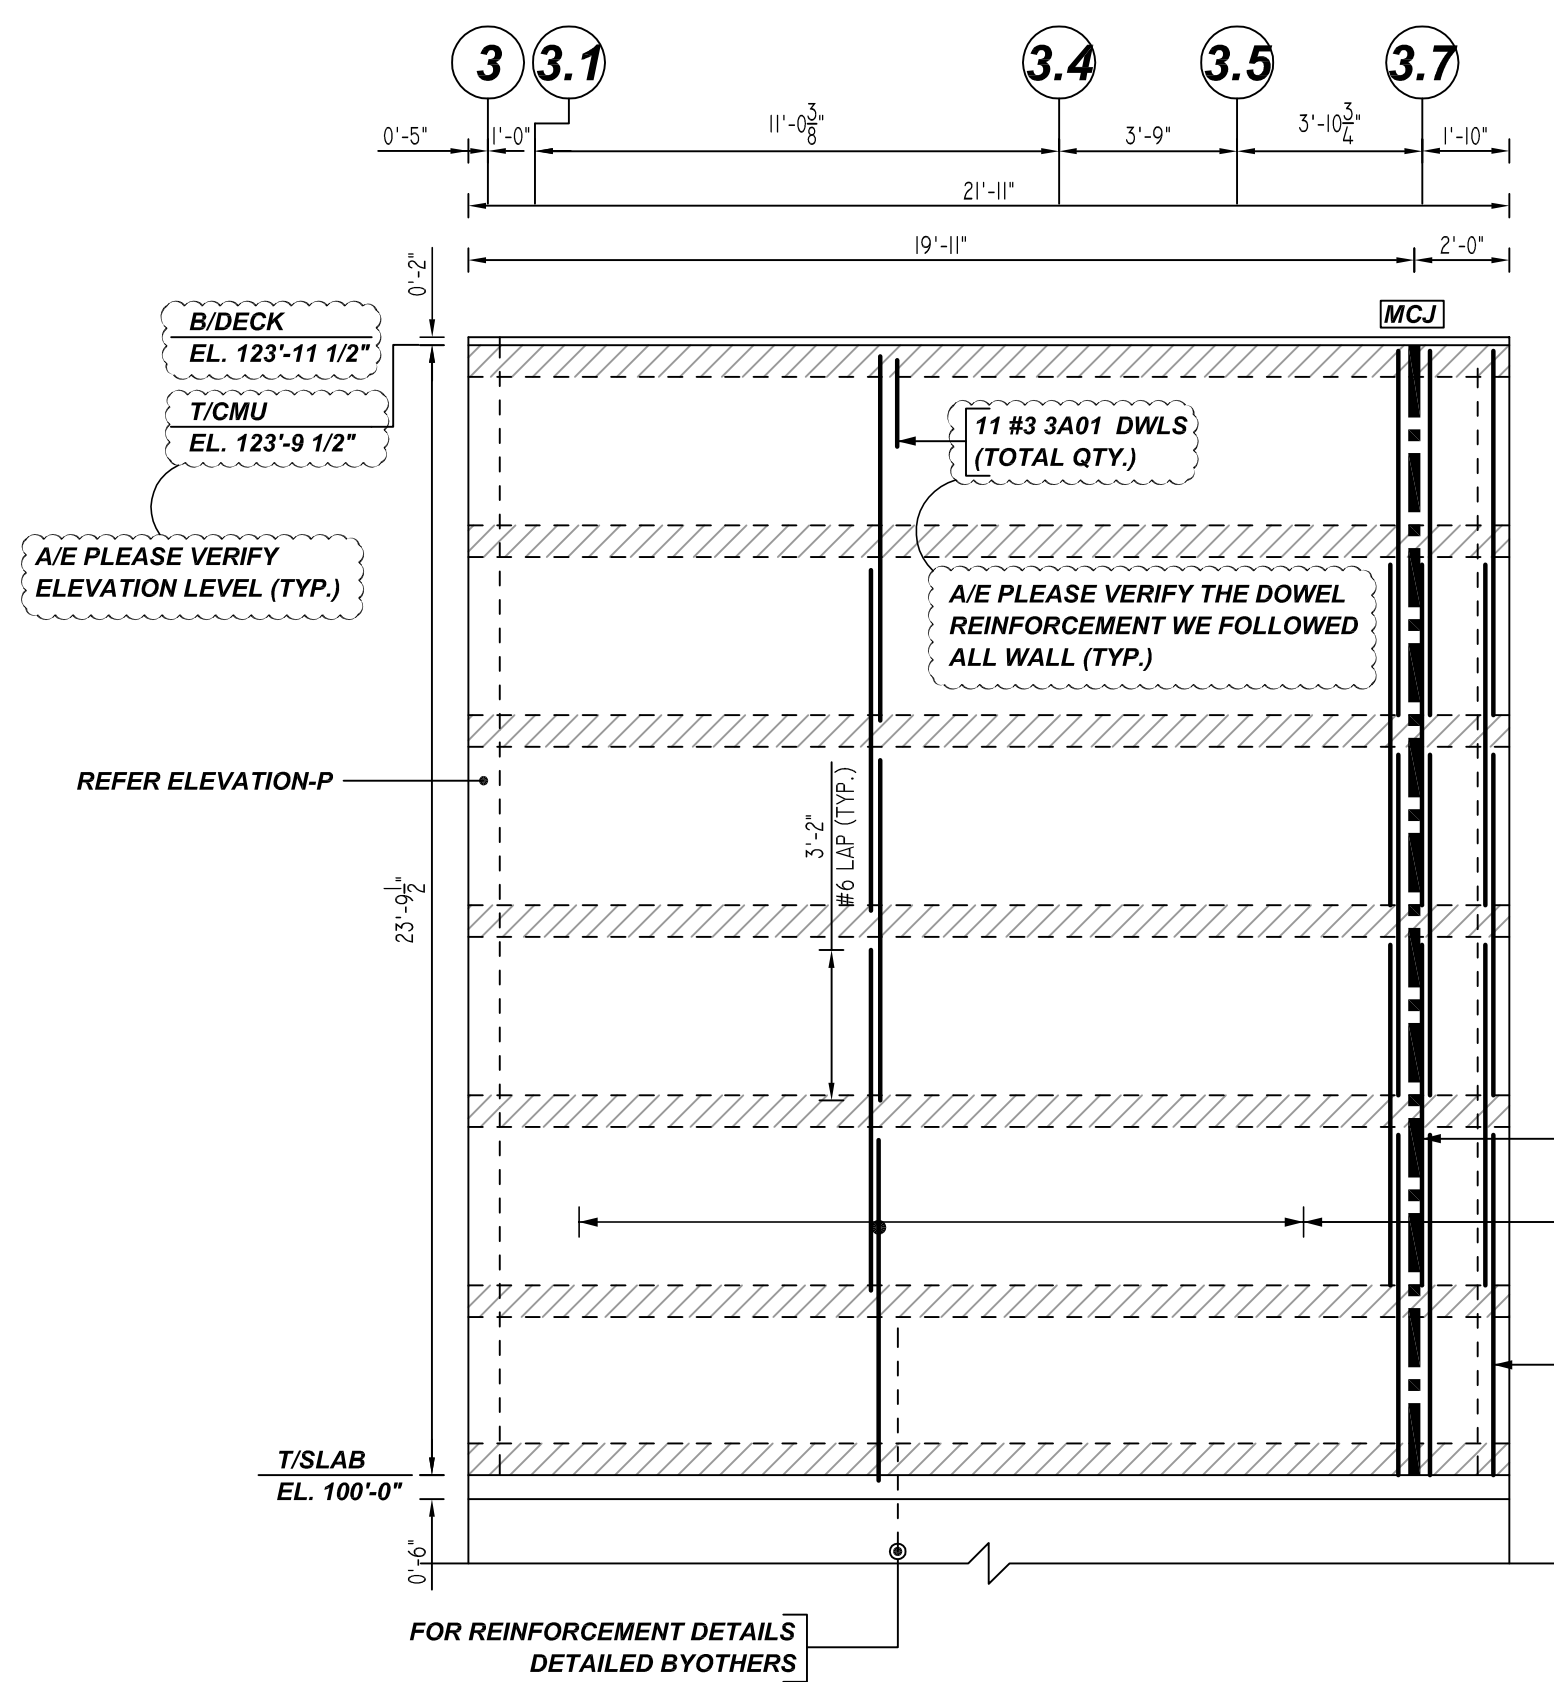


Q ELEVATION
REF: S3.1B
SCALE: 1/4" = 1'-0"

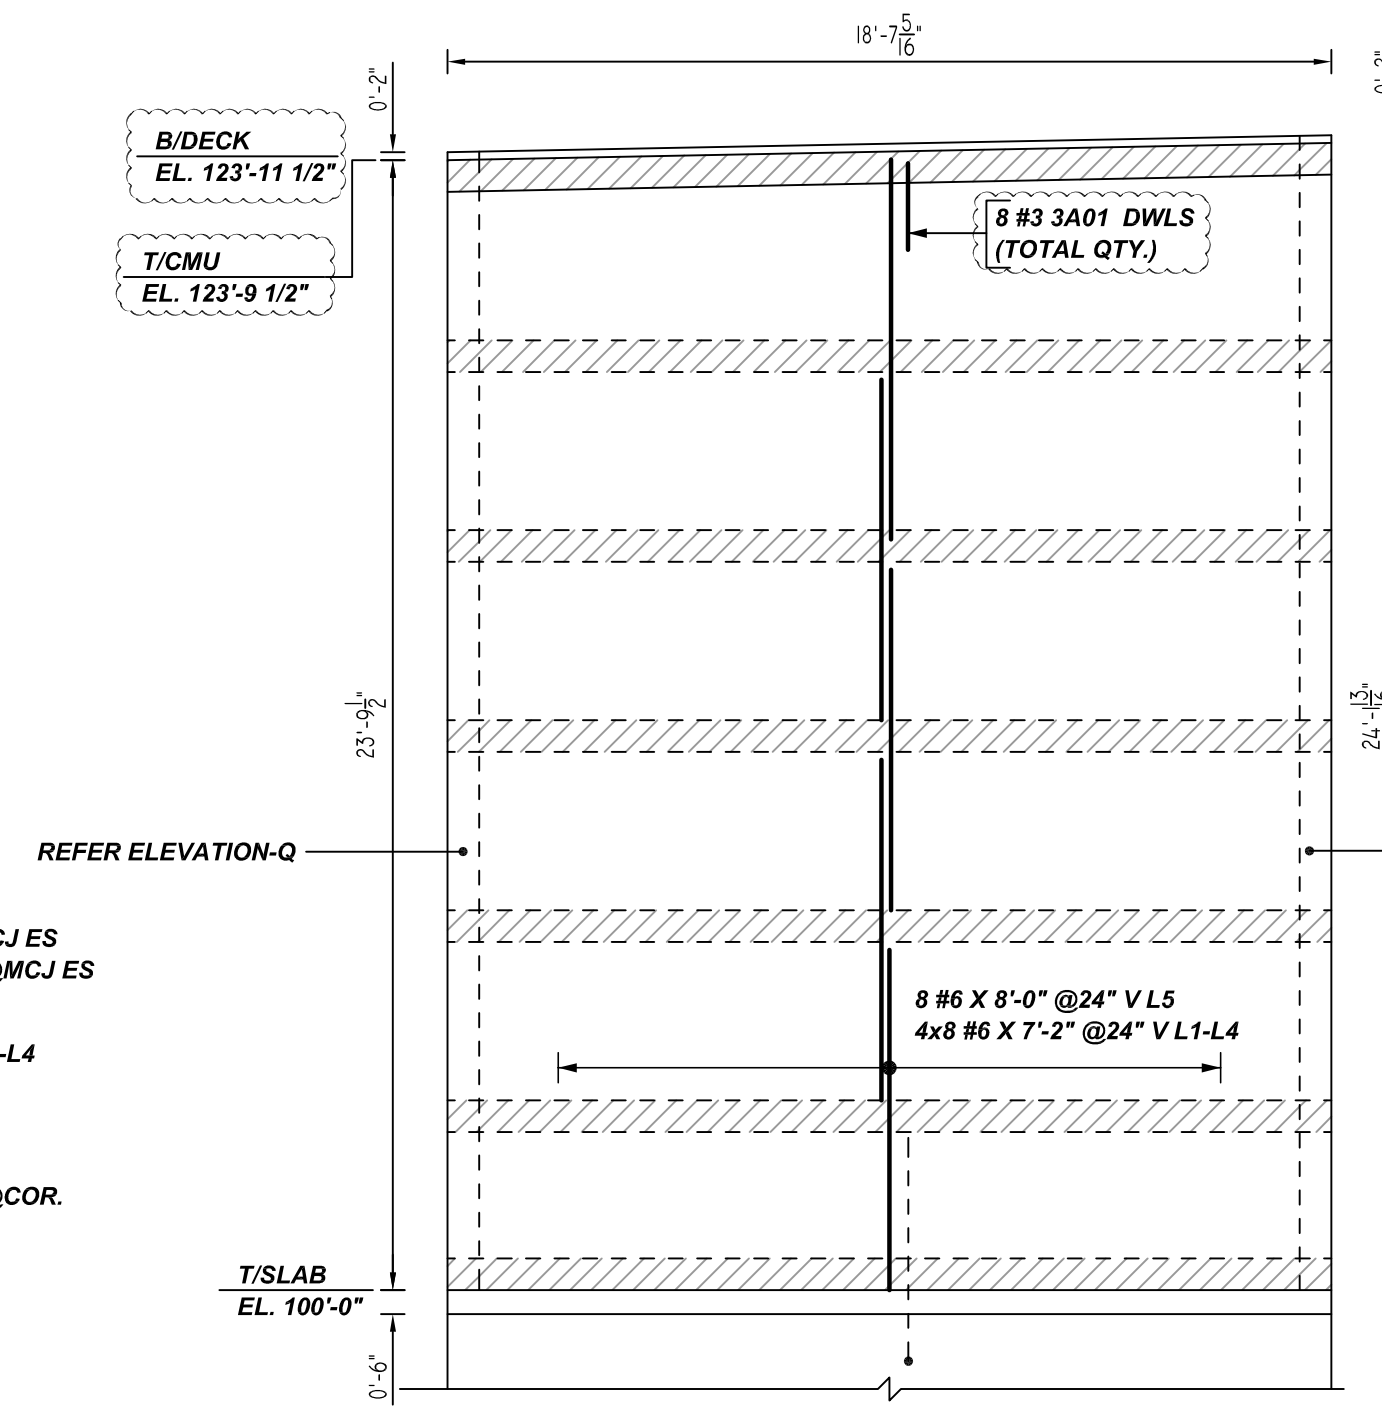


R ELEVATION
REF: S3.1B
SCALE: 1/4" = 1'-0"

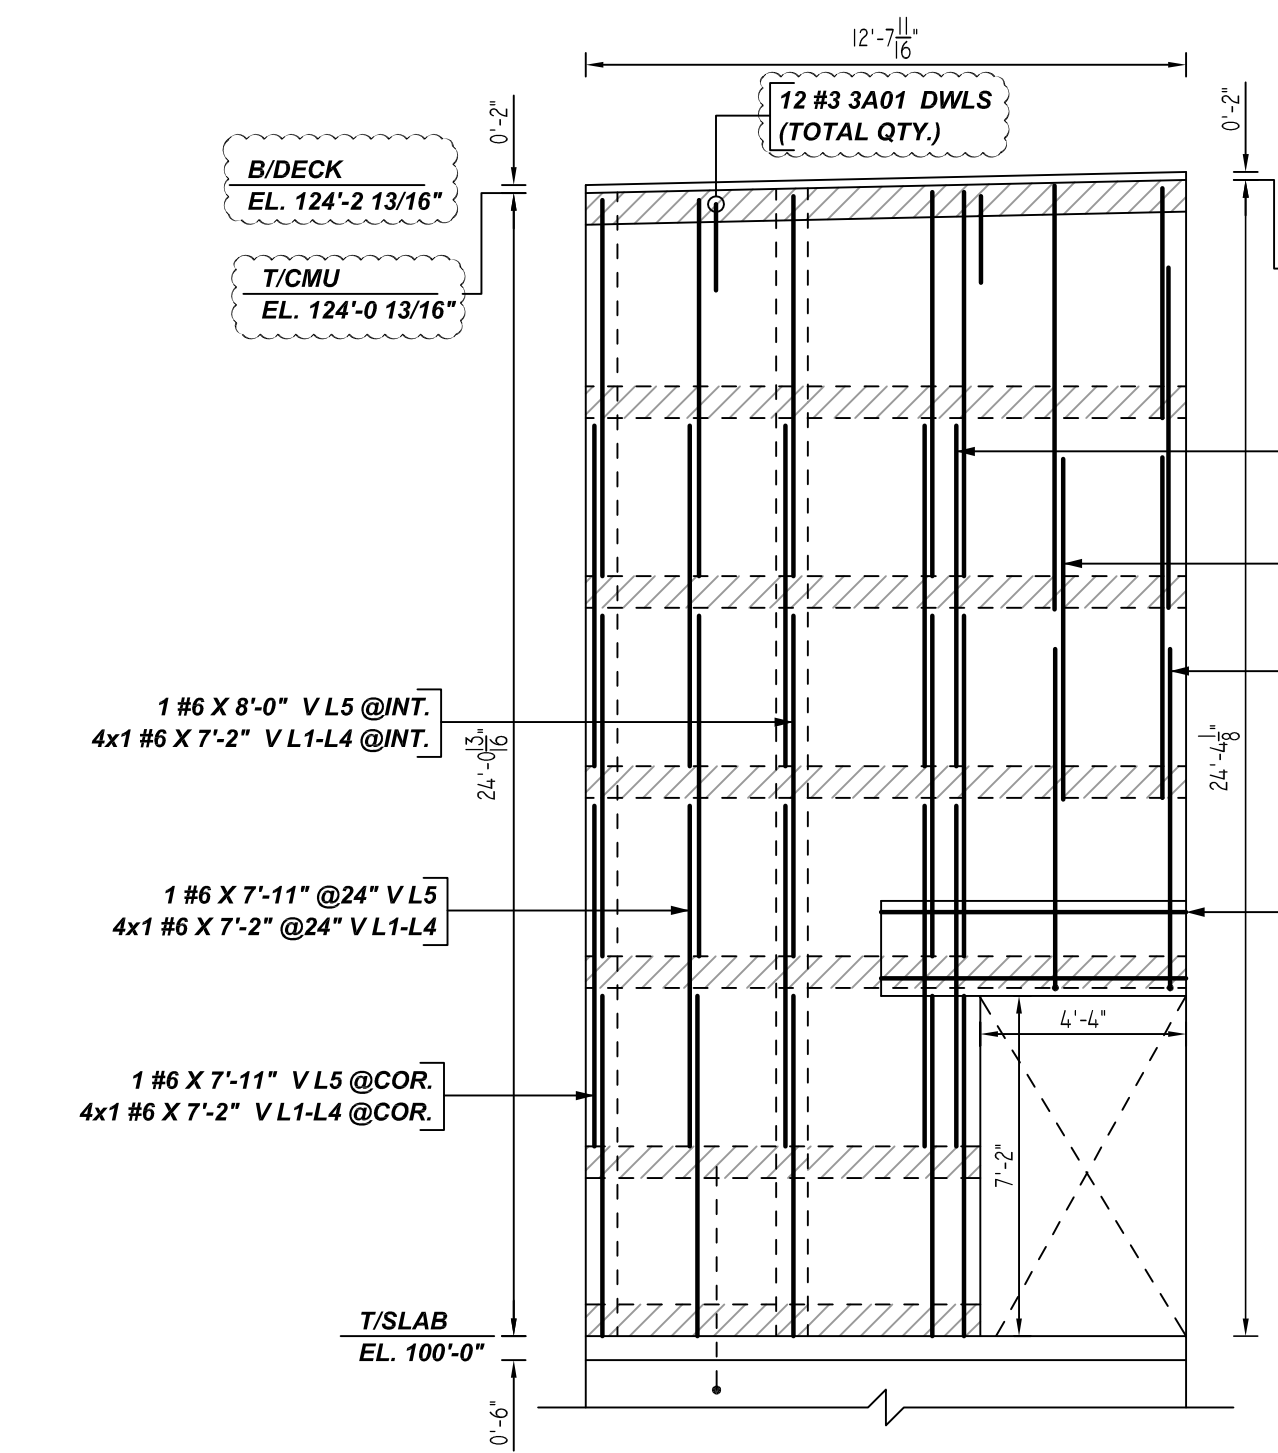


S ELEVATION
REF: S3.1B
SCALE: 1/4" = 1'-0"

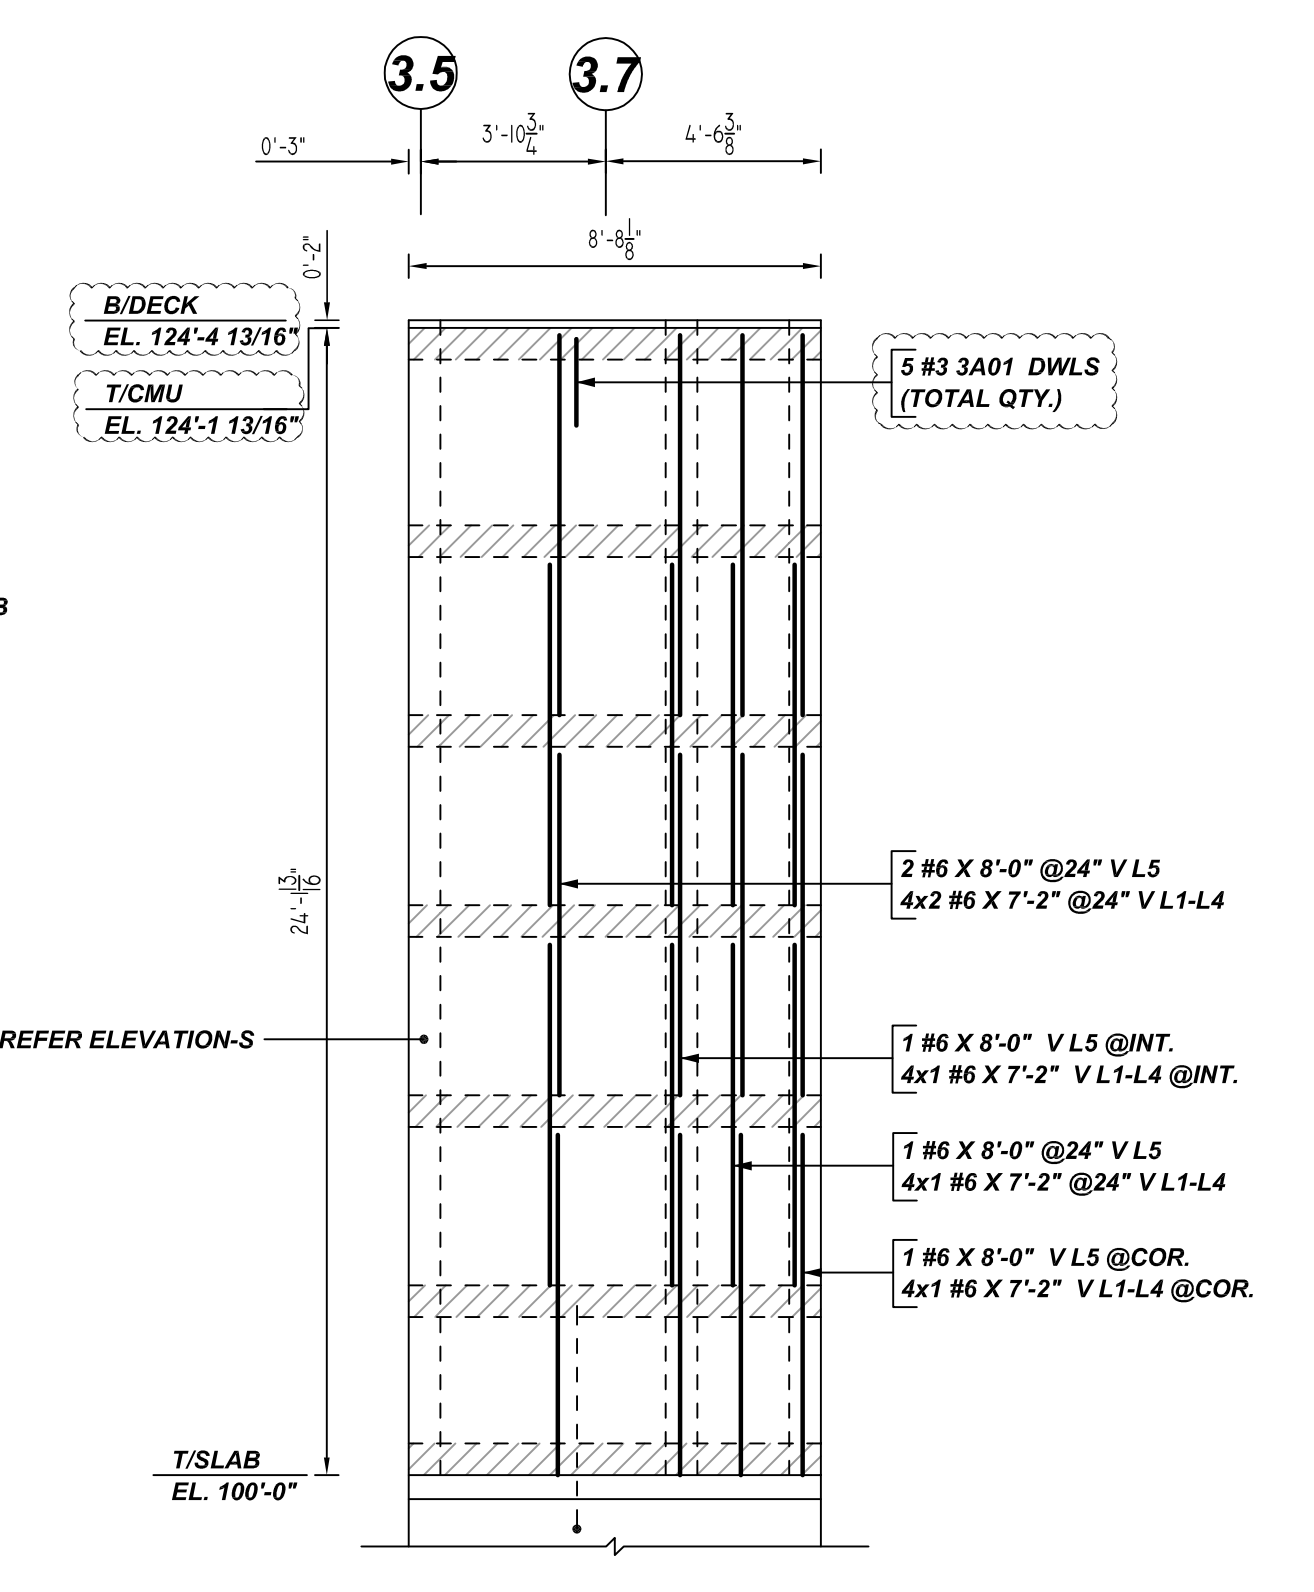


T ELEVATION
REF: S3.1B
SCALE: 1/4" = 1'-0"

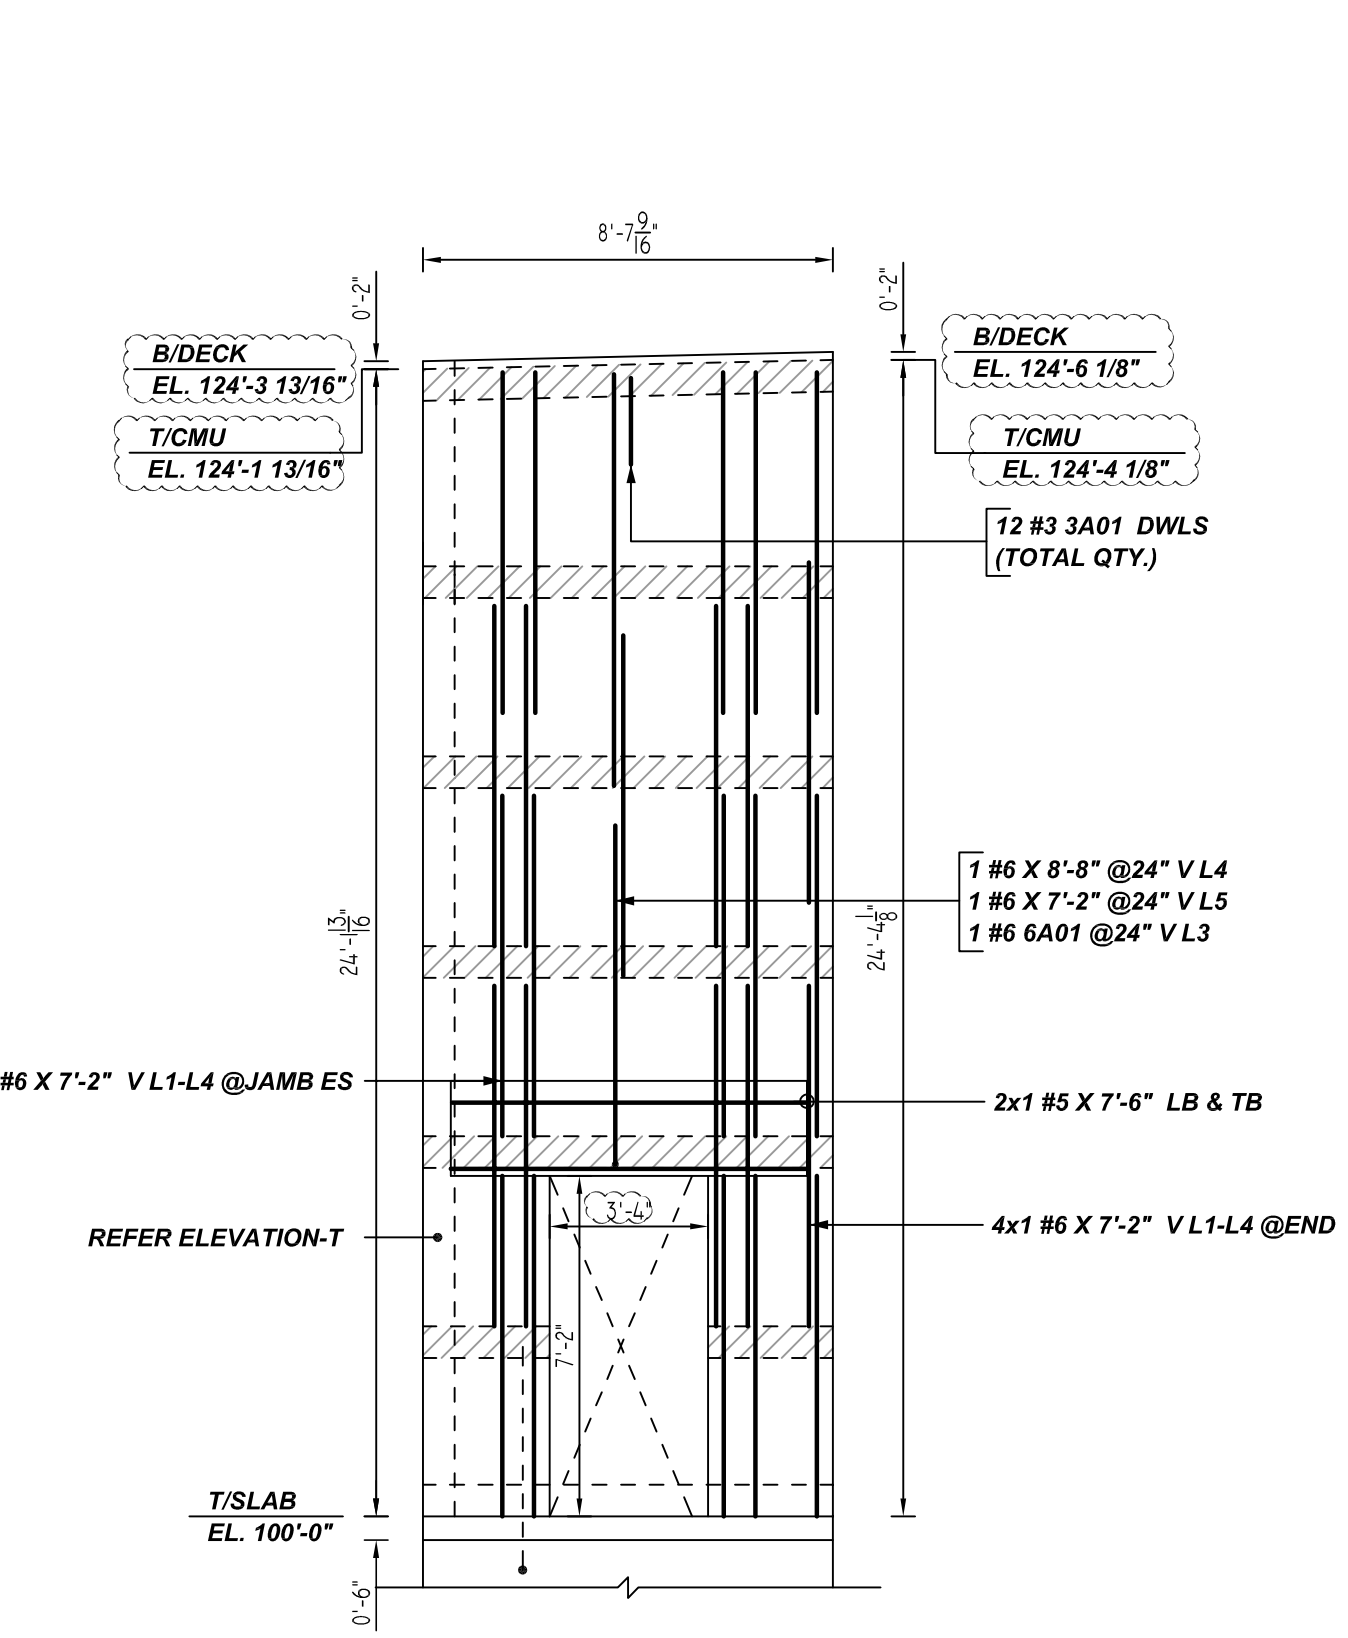

U ELEVATION
REF: S3.1B
SCALE: 1/4" = 1'-0"

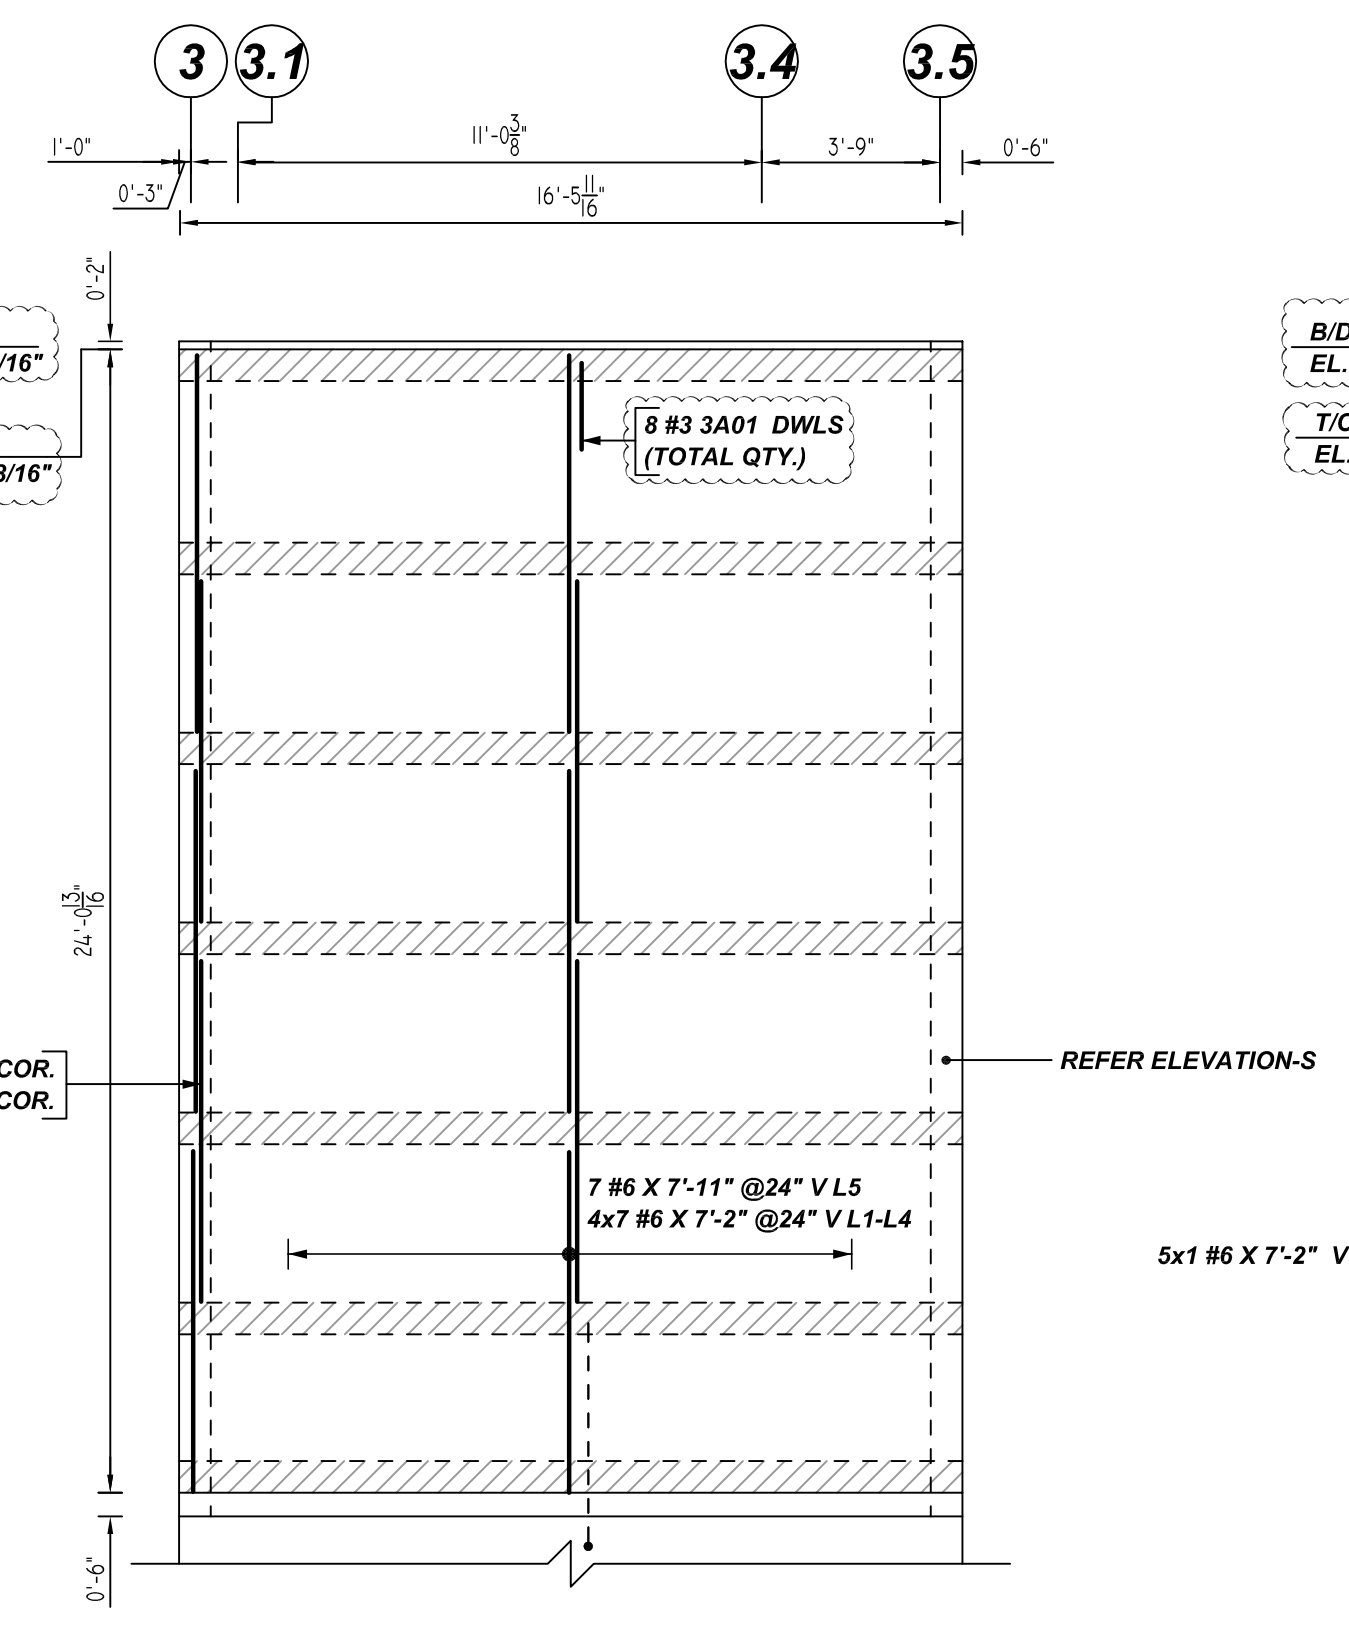


V ELEVATION
REF: S3.1B
SCALE: 1/4" = 1'-0"

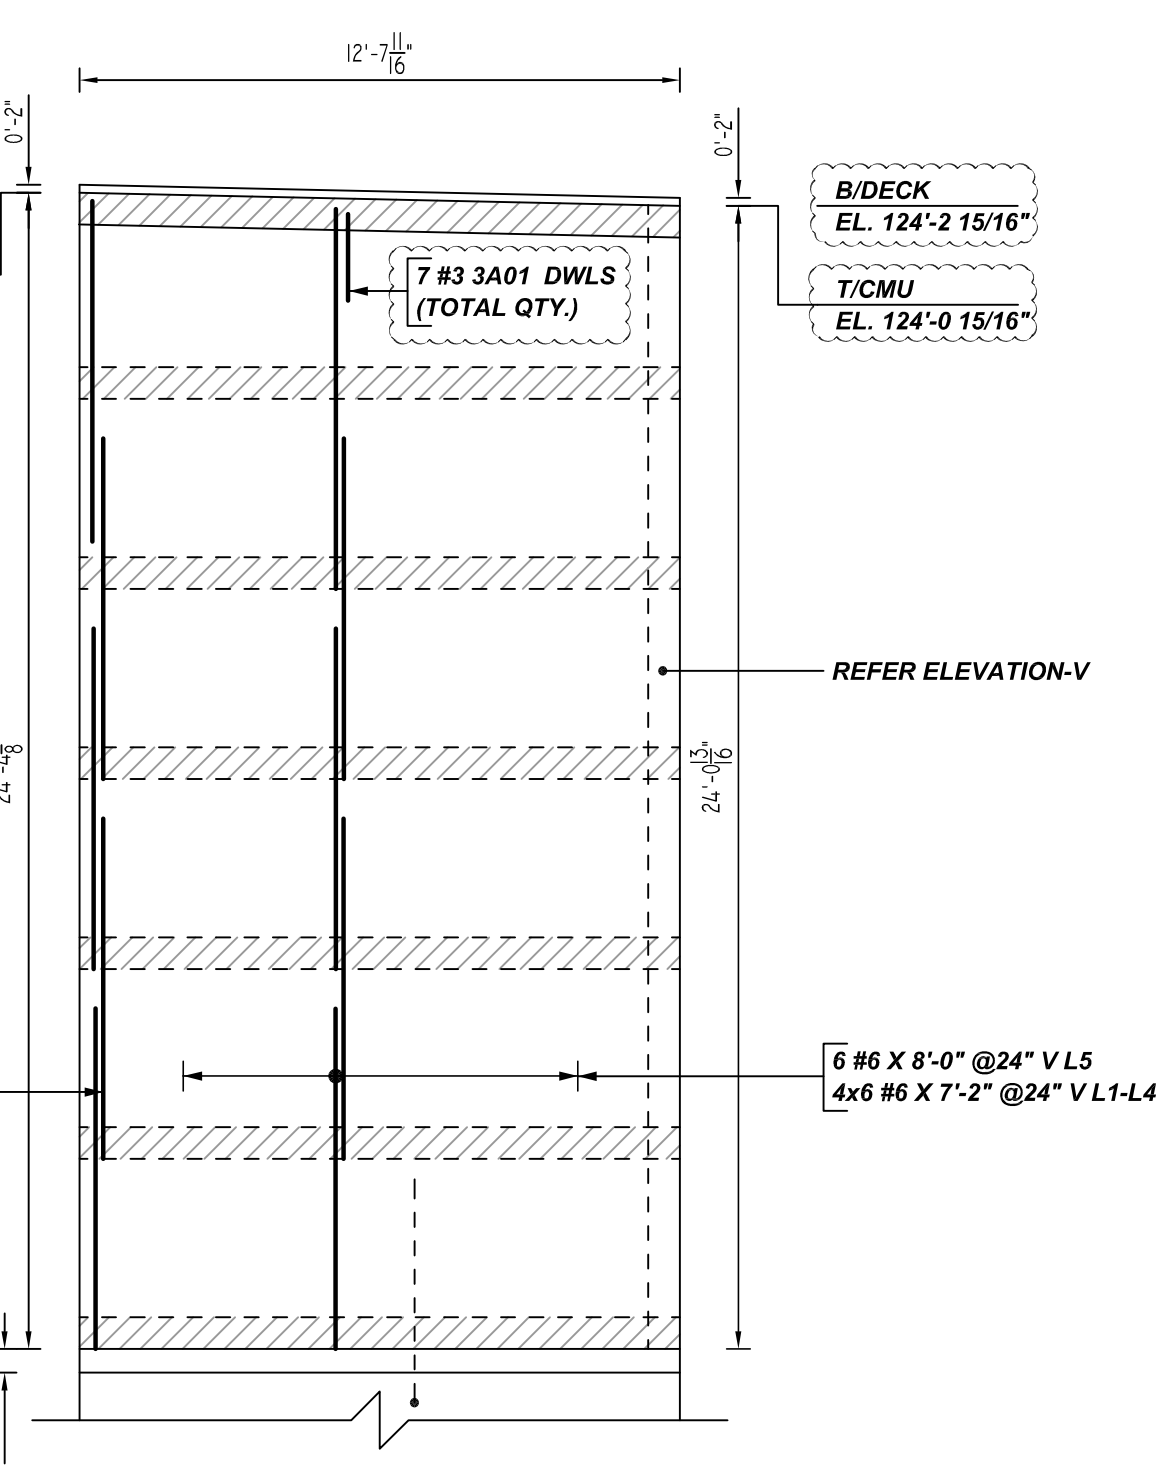

W ELEVATION
REF: S3.1B
SCALE: 1/4" = 1'-0"

Bar No.	Qty	Size	Total Length	Type	X	Y	Z	W	V	U	T	S	R	Q	P
3A01	43	#3	2'-7"	1	0'-5"	1'-10"									
6A01	4	#6	8'-2"	2	1'-0"	7'-2"									

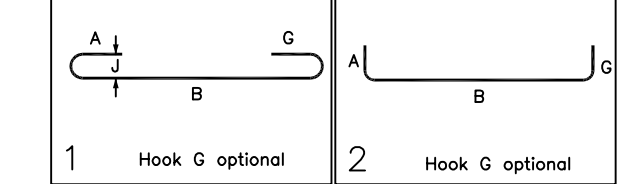

LEGEND

- NO. OF LOCATION
- NO. OF LIFT
- NO. OF BARS
- 2x3x2 #5x6'-6" VERTS
- NO. OF LIFT (OR) NO. OF LOCATION
- NO. OF BARS
- 2x1 #5x6'-6" VERTS
- LIFT 1 TO LIFT 6
- 2x1 #5x6'-6" VERTS L1-L6

LAP SCHEDULE

BAR SIZE	LAP
#3	1'-10"
#4	2'-3"
#5	2'-8"
#6	3'-2"
#7	3'-9"
#8	4'-9"
#9	6'-1"

TYPICAL REINFORCING BAR CLEARANCE TABLE


LOCATION	MIN. COVER
CMU WALL TOP	2" CLR

ALL BARS IN THIS DRAWING
ASTM A615 GRADE 60
BLACK UNCOATED

- PLACING PLAN NOTES**
- THIS DRAWINGS FOR REBAR PLACEMENT ASSISTANCE ONLY. REFER TO STRUCTURAL DETAILS FOR CONTRACT REQUIREMENTS.
 - SECTIONS/DETAILS DIMENSIONS ON PLACING PLAN ARE FOR REFERENCE AND ARE TO BE USED IN CONJUNCTION WITH CONTRACT DRAWING FOR CRSI MANUAL OF STANDARD PRACTICE.
 - REINFORCING STEEL IS DETAILED PER CONTRACT DOCUMENTS ONLY AS SHOWN CODE COMPLIANCE REQUIREMENTS ARE THE RESPONSIBILITY OF ENGINEER AND/OR CONTRACTOR.
 - THE CONTRACTOR UNDERSTANDS THAT THE ENGINEER SHOULD ALWAYS VERIFY SHOP DRAWINGS IF TIME DOES NOT ALLOW FOR APPROVALS. TEXAS REBAR IS NOT HELD RESPONSIBLE FOR UNAPPROVED SHOP DRAWINGS USED IN PLACING CRSI MANUAL OF STANDARD PRACTICE THE CUSTOMER AND ENGINEER SHOULD REVIEW SHOP DRAWINGS PRIOR TO INSTALLATION TO VERIFY ACCURACY TO STRUCTURAL DRAWINGS.
- PLACING PLAN NOTES**
- DIMENSIONS ELEVATIONS & DRAWINGS GRADES SHOWN ARE FOR REFERENCE ONLY CONTRACTOR TO PROVIDE LINES, GRADES & TEMPLATES REQUIRED FOR PLACEMENTS.
 - SECTIONS & DETAILS MAY NOT BE SHOWN ON ALL PLACING PLANS. KEEP STRUCTURAL DRAWINGS ON SITE FOR USE.
 - SOME LAP LENGTHS WILL BE ROUNDED UP IN DETAILING TO PROVIDE FOR 1" INCREMENTS FOR LAPS.
 - LAP OR EMBEDMENT LENGTHS SHOWN IN SPECIFIC DETAILS WILL SUPPERS LAPS IN THE LAP SCHEDULE.
 - VERIFY PLACEMENT DRAWINGS TO LATEST ISSUE OF JOB RECORD DRAWING FOR POSSIBLE REVISIONS OR FIELD CHANGES.
 - TYPICAL NOTES & DETAILS ARE USED THROUGHOUT ENTIRE PROJECT & APPLY UNLESS NOTED OTHERWISE.

REVISION	NO.	DESCRIPTION	DATE
FOR APPROVAL	1		11-08-22
	2		
	3		
	4		


JOB NAME: CDRJ MC KINNEY
JOB NO: 22139
DETAILS OF: AREA-B CMU WALL REINFORCEMENT DETAILS
DATE: 11-08-22
DRAFTER: SSSTR
DRWG: M04
TEXAS REBAR, LLC 817-487-1672

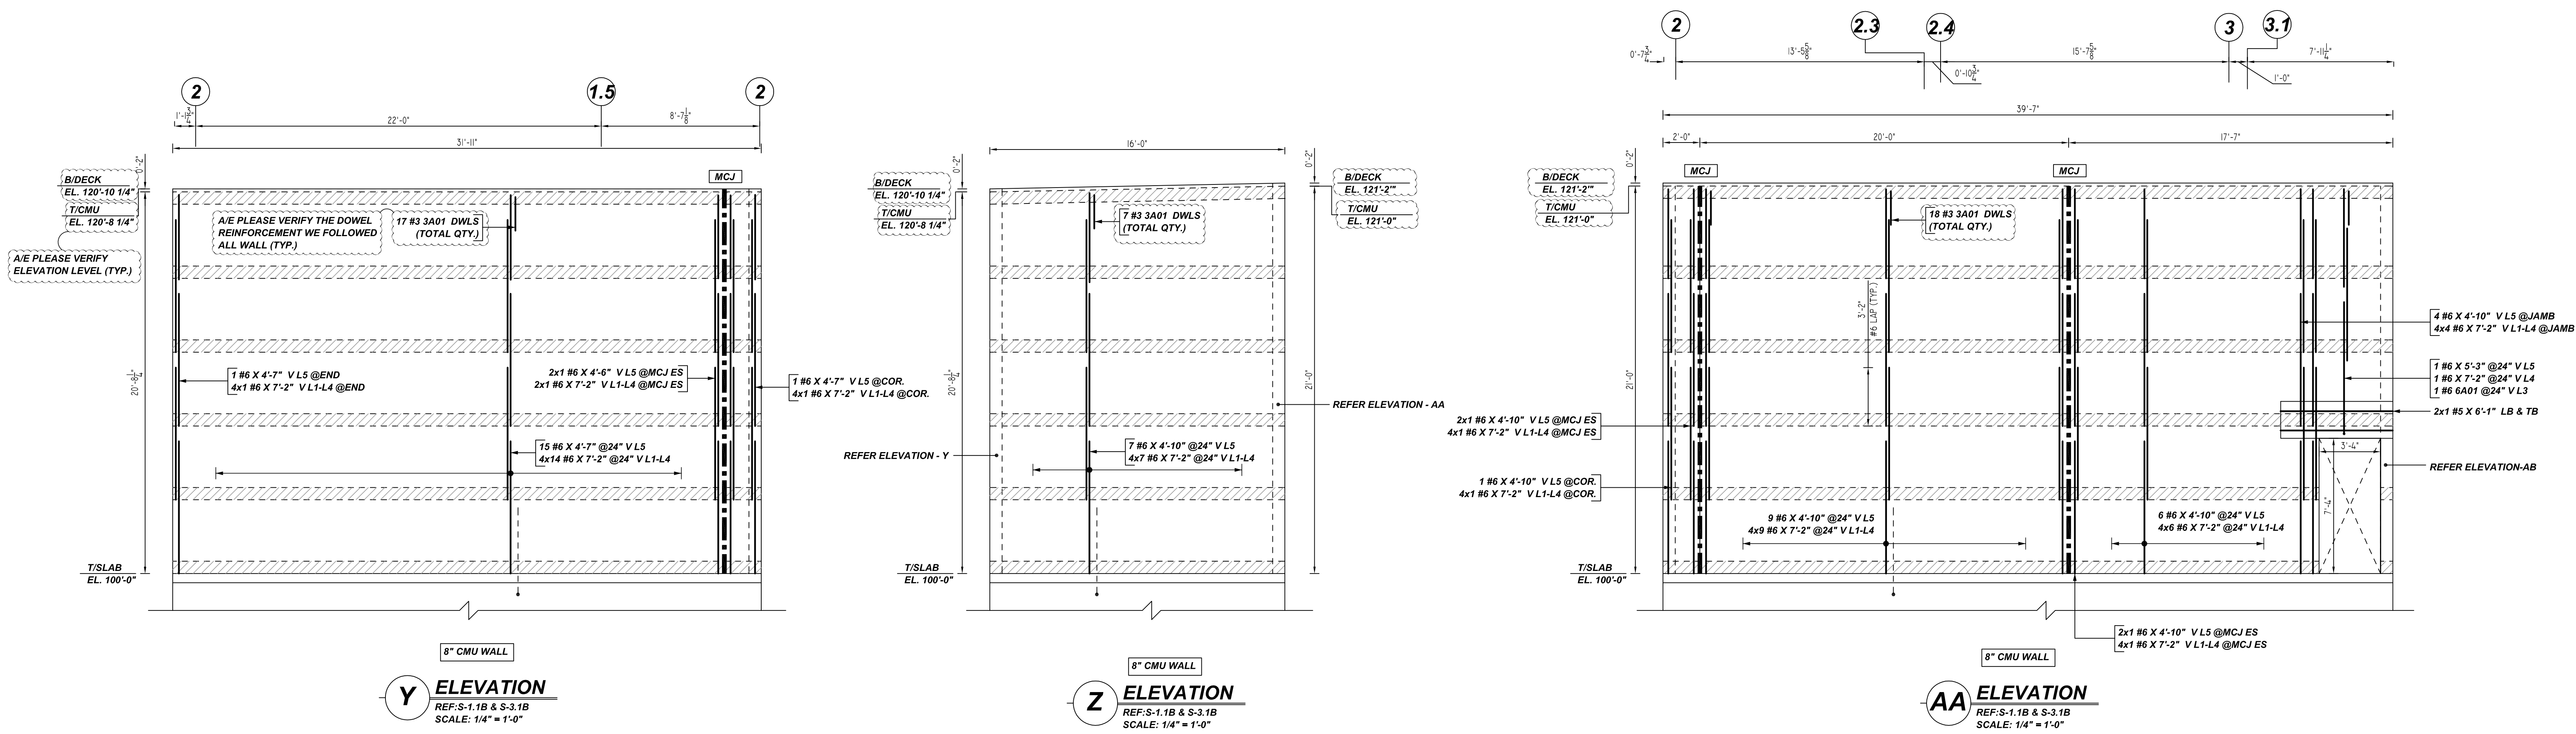


Y ELEVATION
REF: S-1.1B & S-3.1B
SCALE: 1/4" = 1'-0"

Z ELEVATION
REF: S-1.1B & S-3.1B
SCALE: 1/4" = 1'-0"


AA ELEVATION
REF: S-1.1B & S-3.1B
SCALE: 1/4" = 1'-0"

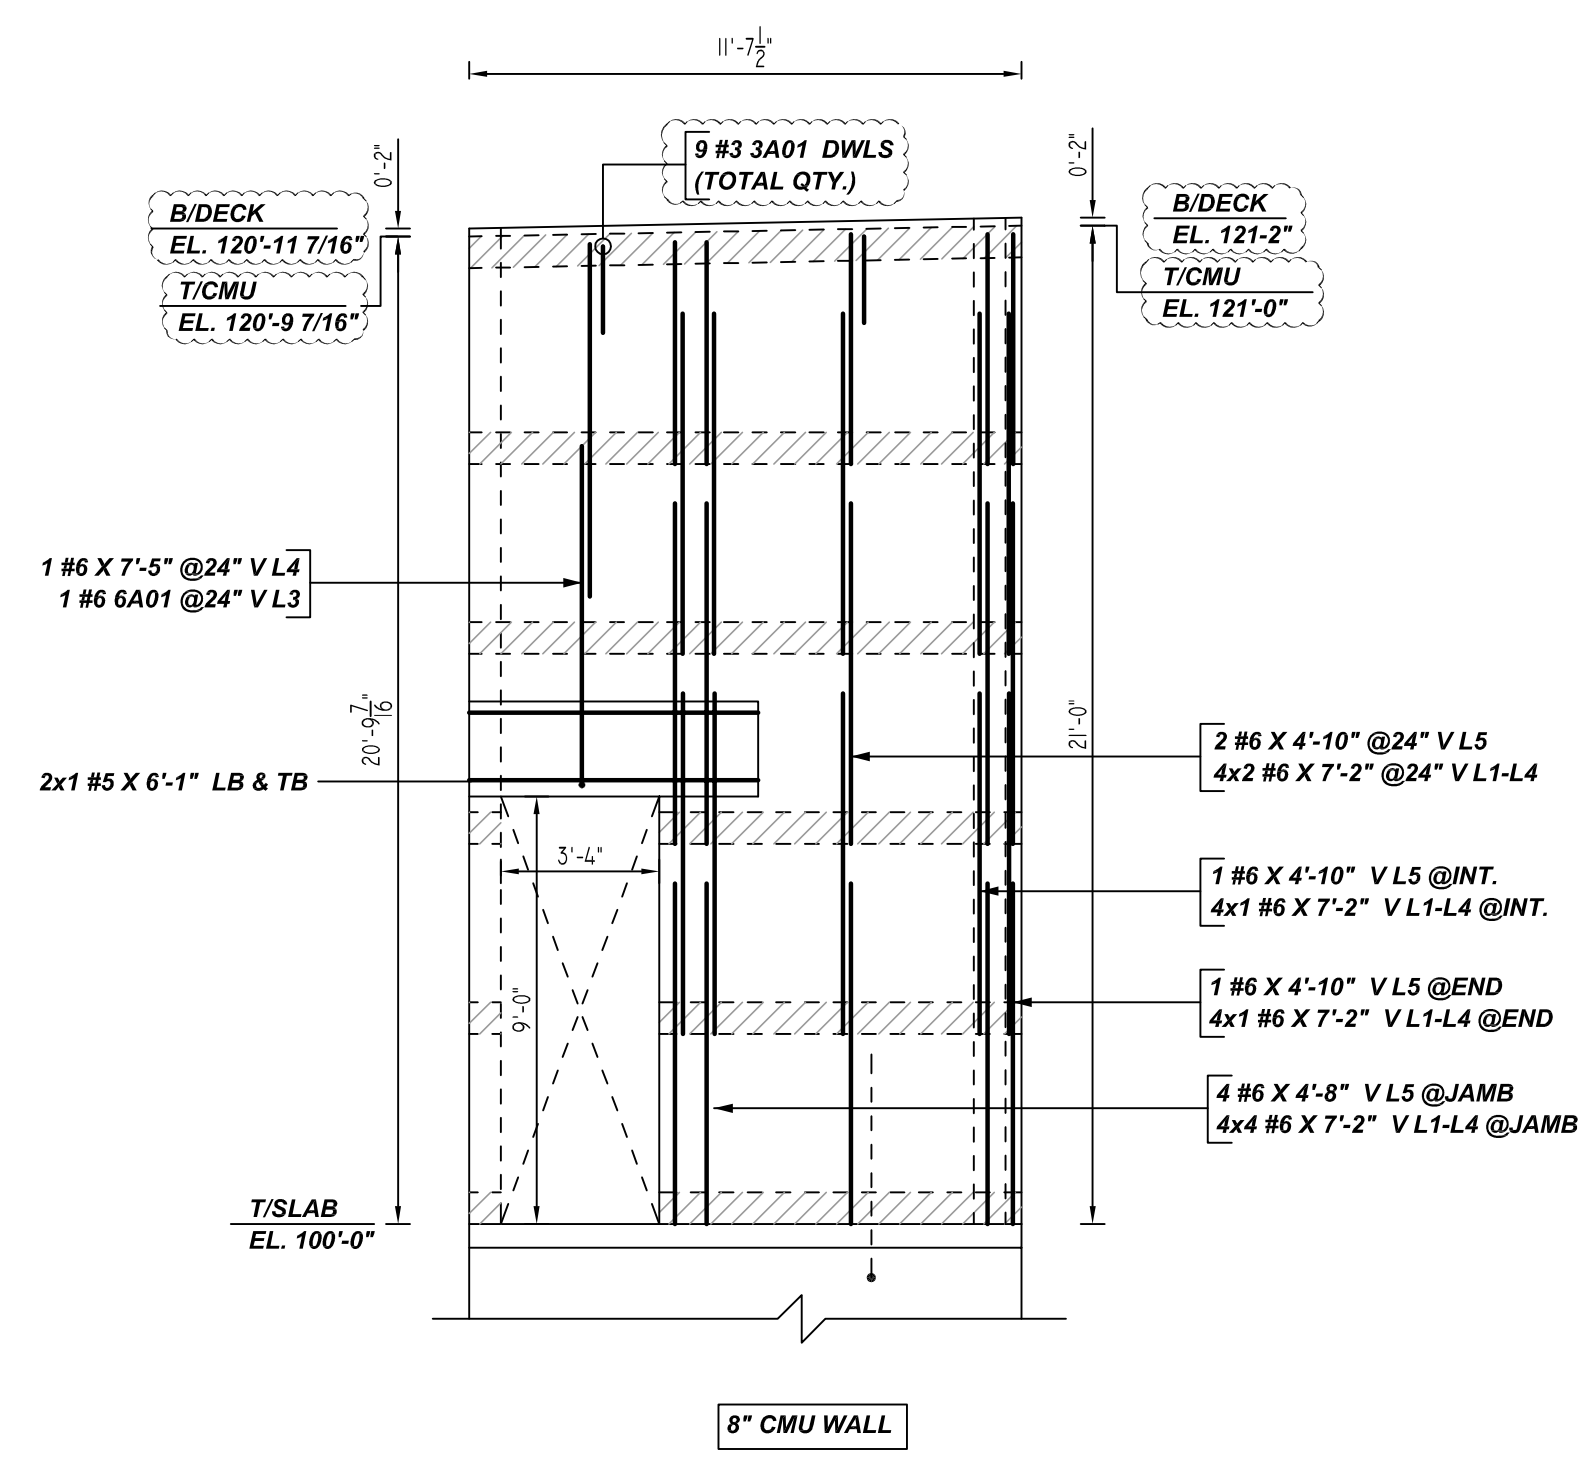

AB ELEVATION
REF: S-1.1B & S-3.1B
SCALE: 1/4" = 1'-0"

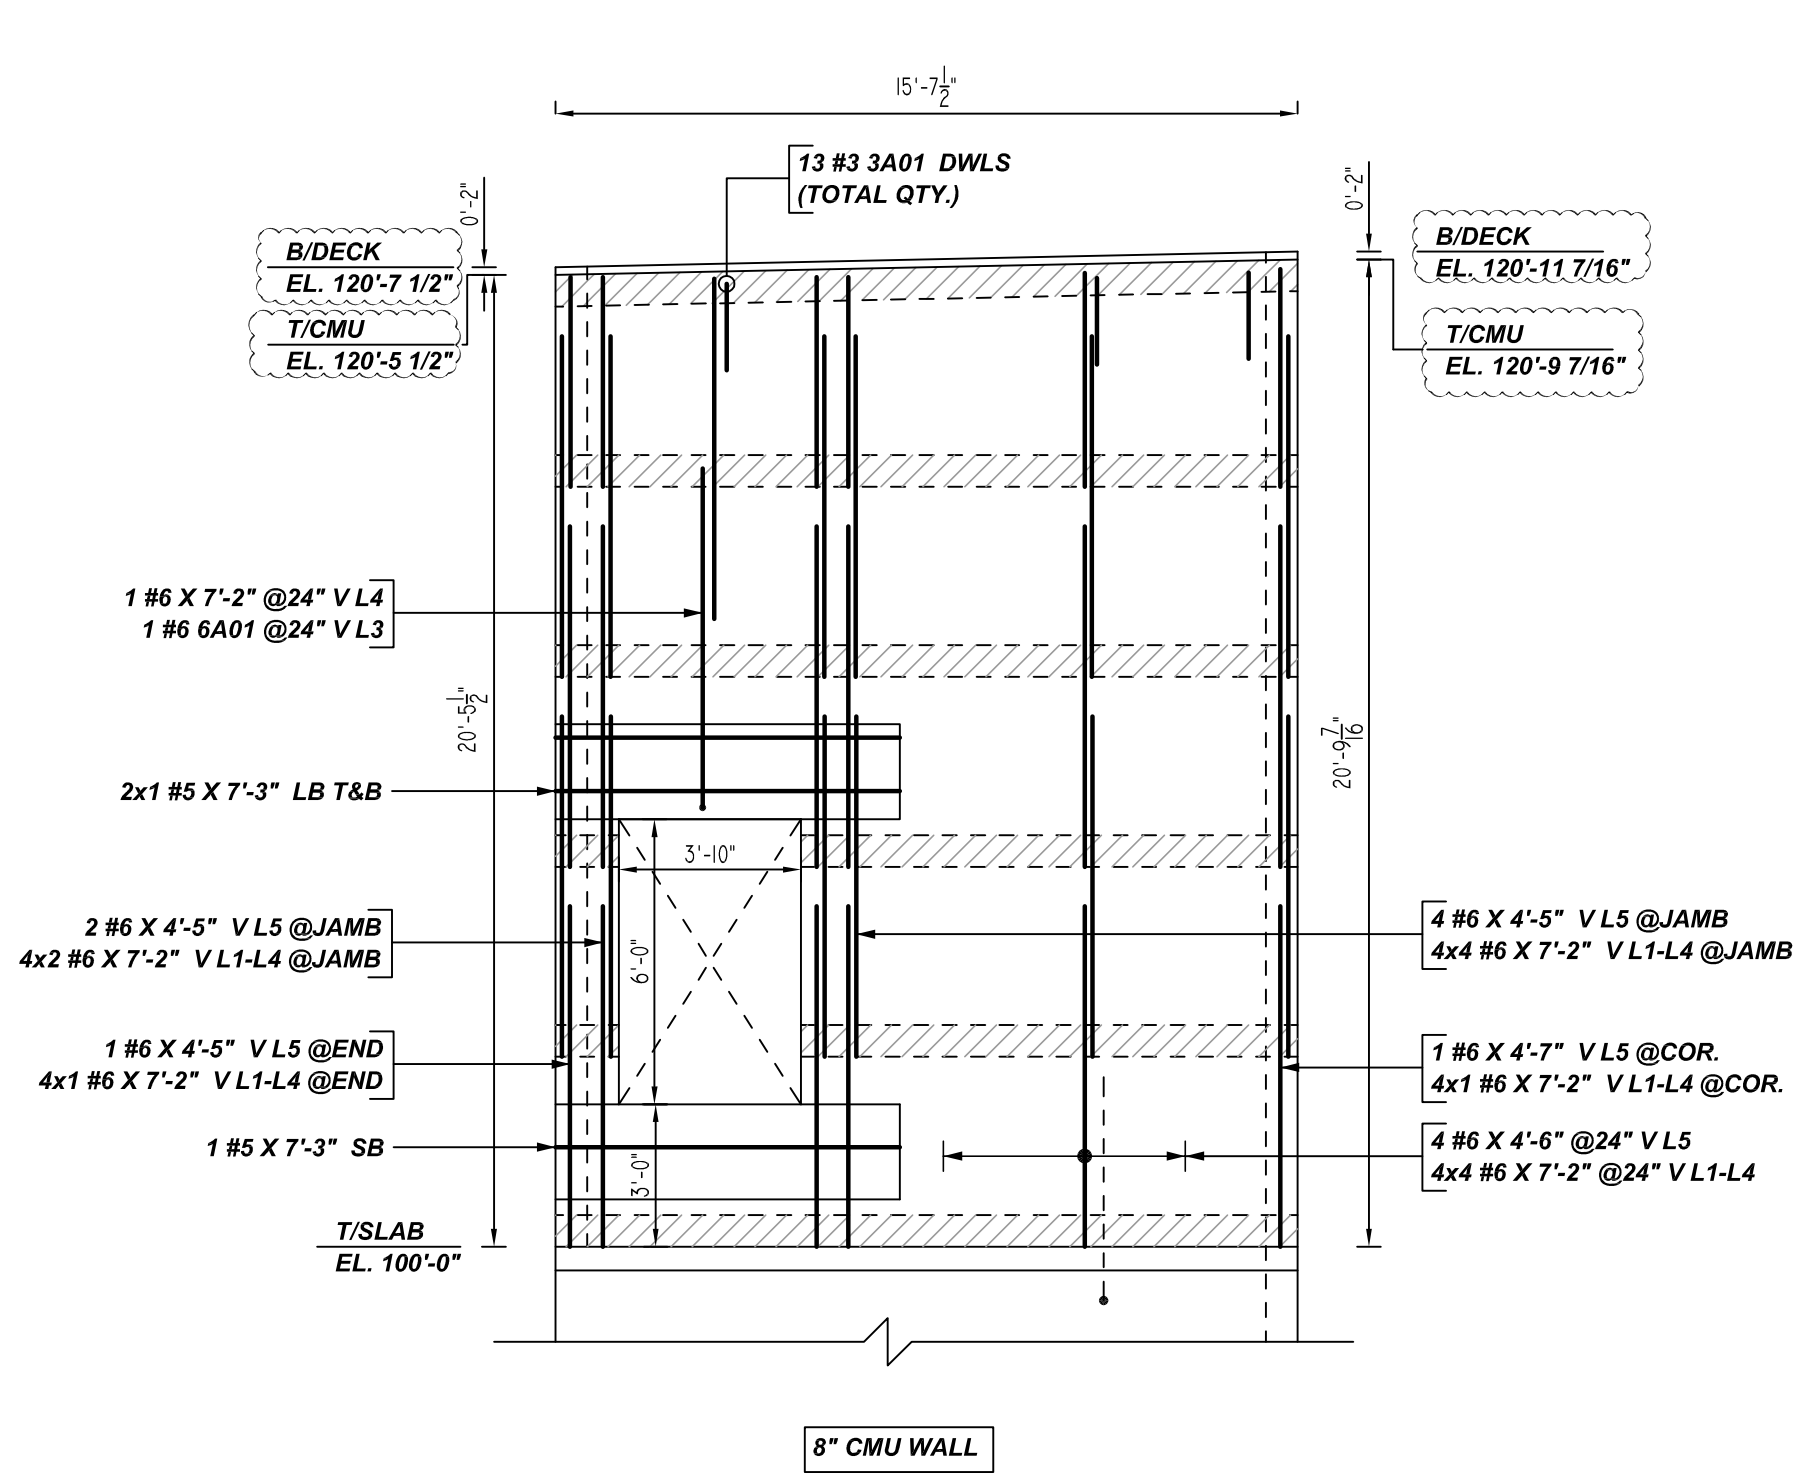


AC ELEVATION
REF: S-1.1B & S-3.1B
SCALE: 1/4" = 1'-0"

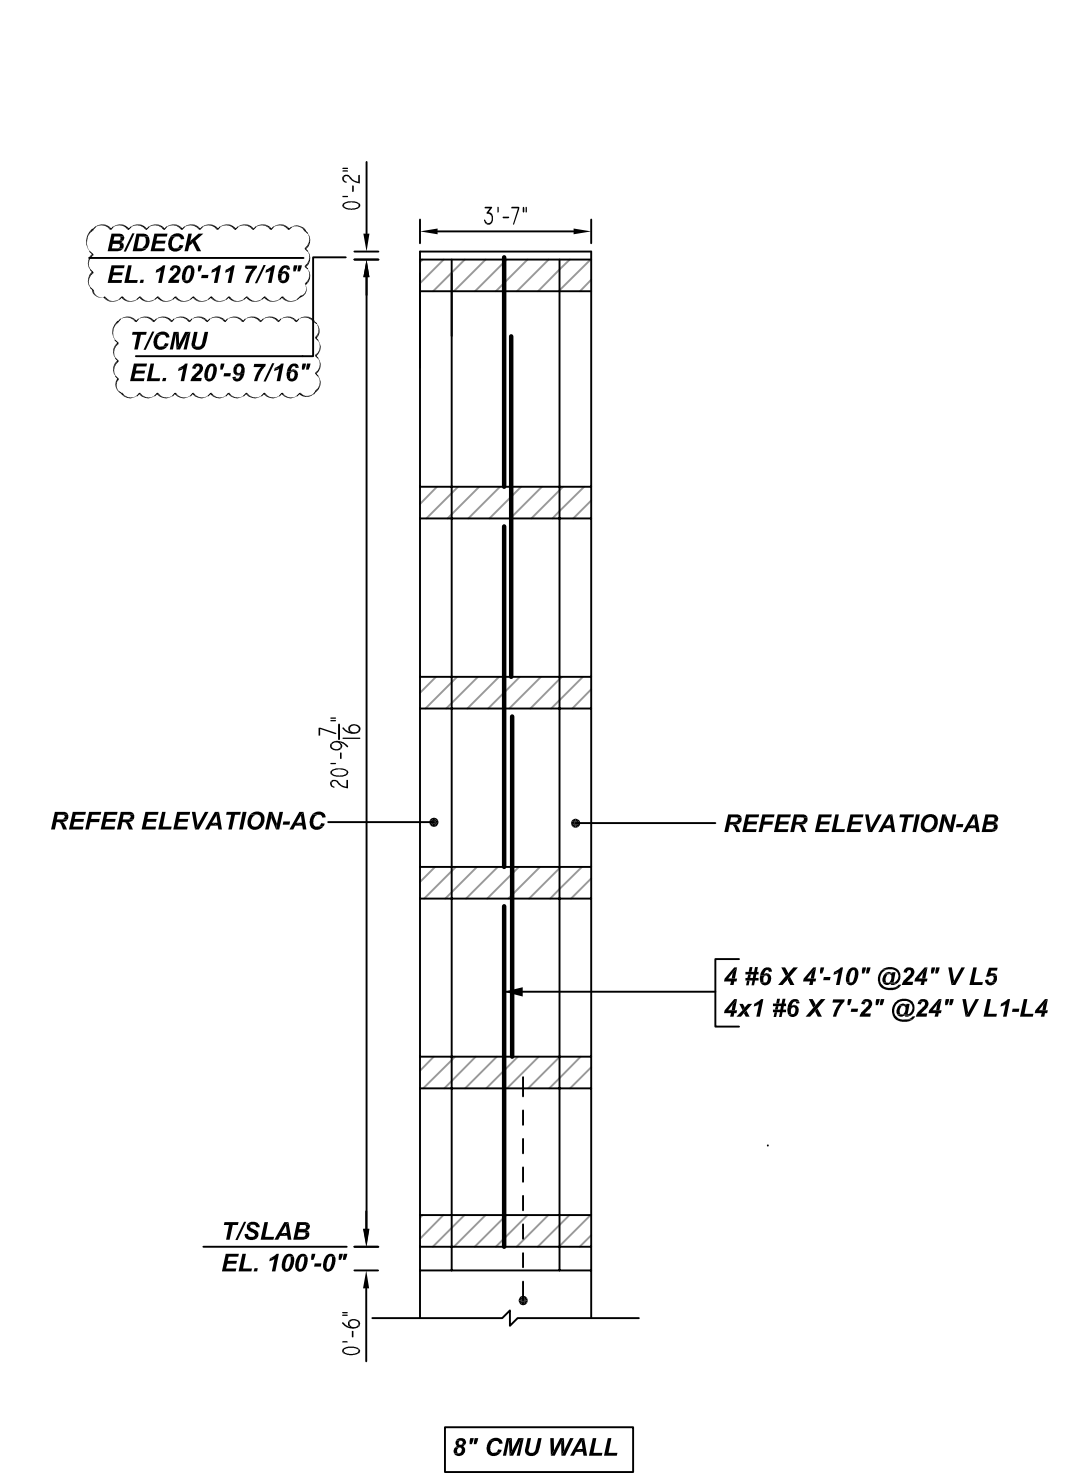

AD ELEVATION
REF: S-1.1B & S-3.1B
SCALE: 1/4" = 1'-0"

Bar Mark	Qty	Size	Total Length	Type	X	Y	Z	AA	AB	AC	AD
3A01	64	#3	2'-3"	1	0'-5"	1'-10"					
6A01	3	#6	8'-2"	2	1'-0"	7'-2"					

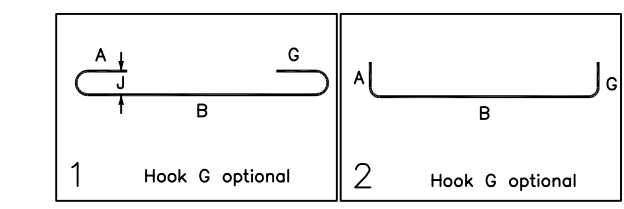

LEGEND

2x3x2 #5x6'-6" VERTS	NO. OF LOCATION
2x1 #5x6'-6" VERTS	NO. OF LIFT
LIFT 1 TO LIFT 6	NO. OF BARS
2x1 #5x6'-6" VERTS L1-L6	NO. OF LOCATION
	NO. OF BARS

LAP SCHEDULE
8" CMU WALL

BAR SIZE	LAP
#3	1'-10"
#4	2'-3"
#5	2'-8"
#6	3'-2"
#7	3'-9"
#8	4'-9"
#9	6'-1"

TYPICAL REINFORCING BAR CLEARANCE TABLE

LOCATION	MIN. COVER
CMU WALL TOP	2" CLR

ALL BARS IN THIS DRAWING
ASTM A615 GRADE 60
BLACK UNCOATED

- PLACING PLAN NOTES**
- THIS DRAWINGS FOR REBAR PLACEMENT ASSISTANCE ONLY. REFER TO STRUCTURAL DETAILS FOR CONTRACT REQUIREMENTS.
 - SECTIONS/DETAILS DIMENSIONS ON PLACING PLAN ARE FOR REFERENCE AND ARE TO BE USED IN CONJUNCTION WITH CONTRACT DRAWING FOR CRSI MANUAL OF STANDARD PRACTICE.
 - REINFORCING STEEL IS DETAIL PER CONTRACT DOCUMENTS ONLY AS SHOWN CODE COMPLIANCE REQUIREMENTS ARE THE RESPONSIBILITY OF ENGINEER AND/OR CONTRACTOR.
 - THE CONTRACTOR UNDERSTANDS THAT THE ENGINEER SHOULD ALWAYS VERIFY SHOP DRAWINGS IF TIME DOES NOT ALLOW FOR APPROVALS. TEXAS REBAR IS NOT HELD RESPONSIBLE FOR UNAPPROVED SHOP DRAWINGS USED IN PLACING CRSI MANUAL OF STANDARD PRACTICE THE CUSTOMER AND ENGINEER SHOULD REVIEW SHOP DRAWINGS PRIOR TO INSTALLATION TO VERIFY ACCURACY TO STRUCTURAL DRAWINGS.
- PLACING PLAN NOTES**
- DIMENSIONS ELEVATIONS & DRAWINGS GRADES SHOWN ARE FOR REFERENCE ONLY CONTRACTOR TO PROVIDE LINES, GRADES & TEMPLATES REQUIRED FOR PLACEMENTS.
 - SECTIONS & DETAILS MAY NOT BE SHOWN ON ALL PLACING PLANS. KEEP STRUCTURAL DRAWINGS ON SITE FOR USE.
 - SOME LAP LENGTHS WILL BE ROUNDED UP IN DETAILING TO PROVIDE FOR 1" INCREMENTS FOR LAPS.
 - LAP OR EMBEDMENT LENGTHS SHOWN IN SPECIFIC DETAILS WILL SUPPRESS LAPS IN THE LAP SCHEDULE.
 - VERIFY PLACEMENT DRAWINGS TO LATEST ISSUE OF JOB RECORD DRAWING FOR POSSIBLE REVISIONS OR FIELD CHANGES.
 - TYPICAL NOTES & DETAILS ARE USED THROUGHOUT ENTIRE PROJECT & APPLY UNLESS NOTED OTHERWISE.

NO.	DATE	DESCRIPTION
0	11-08-22	FOR APPROVAL
1		
2		
3		

JOB NAME: CDRJ MC KINNEY
 JOB NO: 22139
 DETAILS OF: AREA-B CMU WALL REINFORCEMENT DETAILS
 DATE: 11-08-22
 DETAILER: SSSTR
 DRWG: M05
 TEXAS REBAR, LLC 817-487-1672

